




TOWN OF LEXINGTON — BOARD OF PUBLIC WORKS

WATER DIVISION

Sketch of Service Here

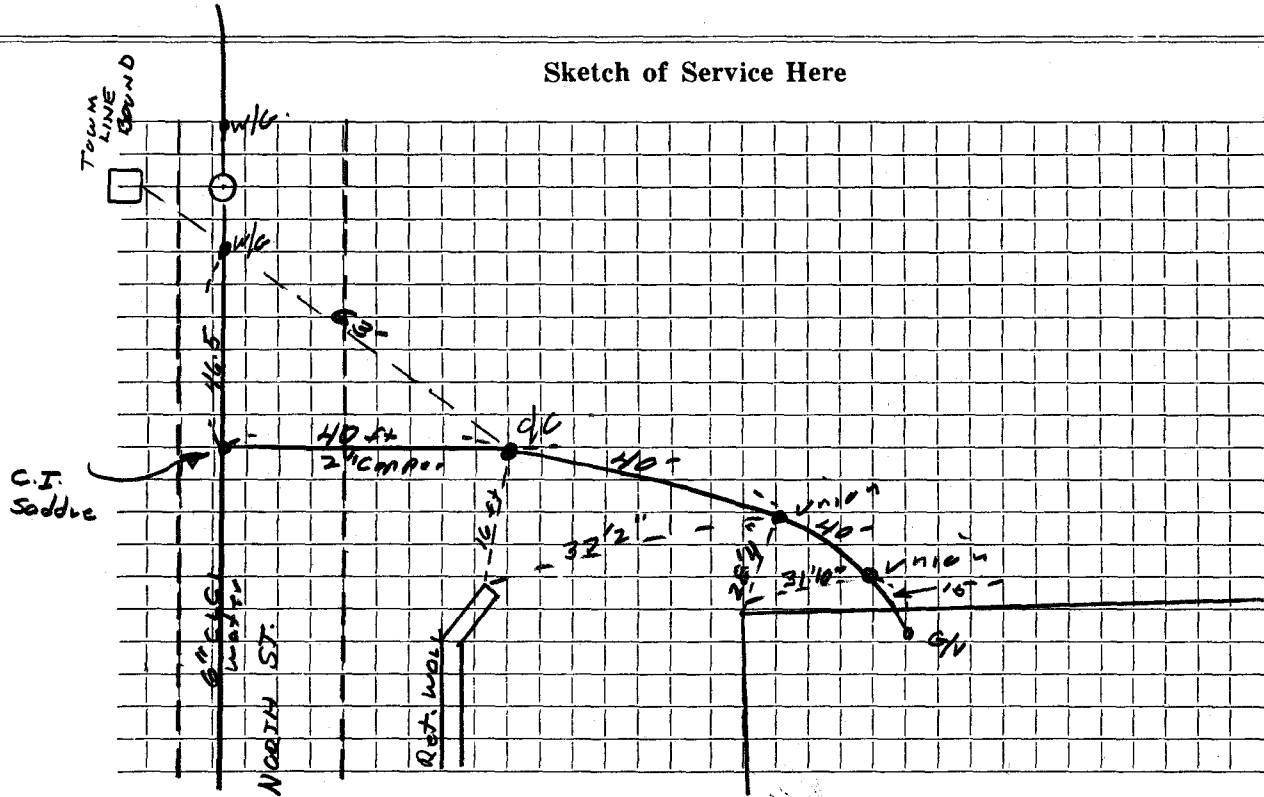

Connection made in ... N ..... Street. Work completed .....

Remarks: .....  
.....  
.....