


DATE 7/11/12

TOWN OF LEXINGTON — BOARD OF PUBLIC WORKS
WATER DIVISION

Sketch of Service Here

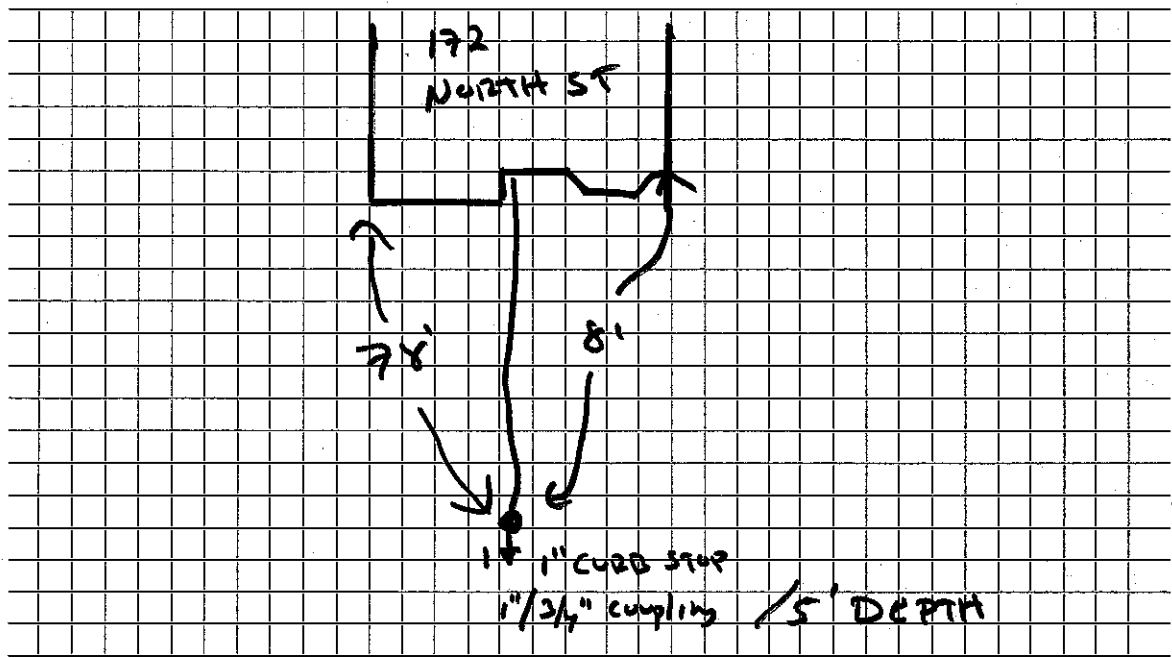

Connection made in... NORTH Street. Work completed... TAYLOR EXCAVATION

Remarks: ... OLD 3/4\" CURB DURIEN, LEFT ON