

Name William Cass, Jr.

Service No. 224

Address 20 North Street

Lexington, Mass.

Locatio 20 North Street

Kind of Pipe

Size

Size of Main

~~Repair-Renewal~~ New Service

Com. 11-6-50

Location

Date	Material	Amount	Total	Date	Location	Amount
Sept. 12, '50	Labor	11 60	11 60	Aug 15 '50	Deposited	65 00
	10% Overhead		1 16			0 7
	62' - 3/4" Copper Tubing @.275		17 05		No Charge	59 93
	1 - 3/4"C x 1/2" I.W.H. S&W		3 76	Sept. 12, '50	Labor	10 00
	1 - 3/4"C x 3/4"C Union (3pts)		1 62	7' - 3/4" Copper Tubing @.275		1 93
	Littlefield Shovel 3 hrs. @7.00		21 00	1 - 3/4"C Corp-cock		3 60
	Trucking 1 hr. @.75		75	1 - 3/4"C x 3/4"C Curb-cock		4 40
	Patching 3 x 3		3 00	1 - Box & Rod		3 35
			59 93	1 - 1/2" Offset Tail Piece		42
				1 - 1/2" Straight Tail Piece		42
				Littlefield Shovel 1 hr. @ 7.00		7 00
				Trucking 1 hr. @.75		75
	Labor					31 87

DATE _____

TOWN OF LEXINGTON—BOARD OF PUBLIC WORKS

WATER DIVISION

The undersigned applies for a supply of water at No. _____ St. and hereby agrees to comply with the rules and regulations as now, or at any future time, established by the Board of Selectmen.

Am't. of Estimate \$ _____


Owner _____

Am't. Paid \$ _____

Address _____

Builder _____

Sketch of Service Here

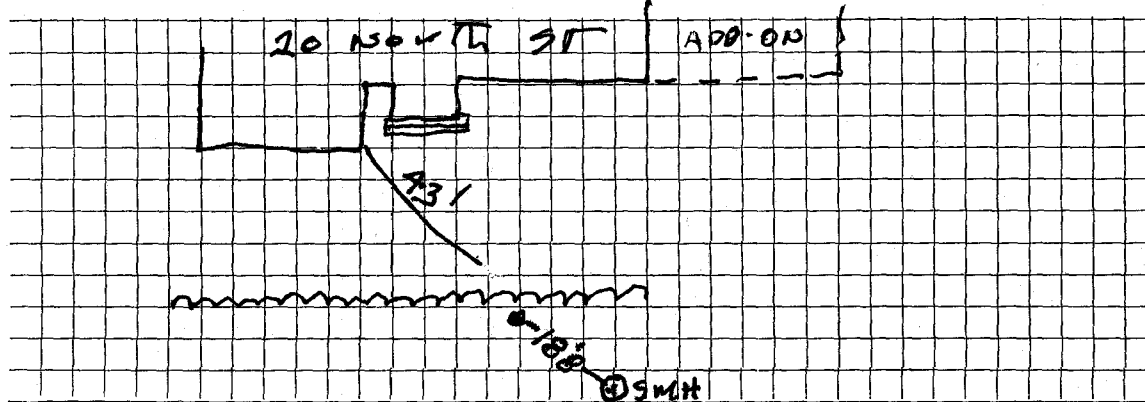

Connection made in _____ Street.

Work completed _____ 19

Remarks: