

WATER SERVICE RECORD

Name Dave Zaloga

Service No. 27

Address 21 North St. Lexington, Mass.

Location

~~Repair~~ New Service WO #4565 Devine #2834

Comm 8-1976


Date	Material	Amount	Total	Date	Amount
6/7/76	labor	100.96		6-3-76	250.00
6/17/76	labor	47.72	148.68		366.21
	10%OH	14.87			
			163.55		
25'	1" copper @ .83		20.75		
1	1" curb		18.67		
1	1" corp		16.69		
1/2	ton cold patch		6.85		
1	curb box and rod		15.40		
1	trench 7 X 20		93.30		
4	hr. truck @ 3.00		12.00		
1	hr. compressor		5.00		
1/2	hr. roller		1.00		
2	hr. shovel @ 6.50		13.00		
			366.21		

DATE _____

TOWN OF LEXINGTON — BOARD OF PUBLIC WORKS

WATER DIVISION

Sketch of Service Here

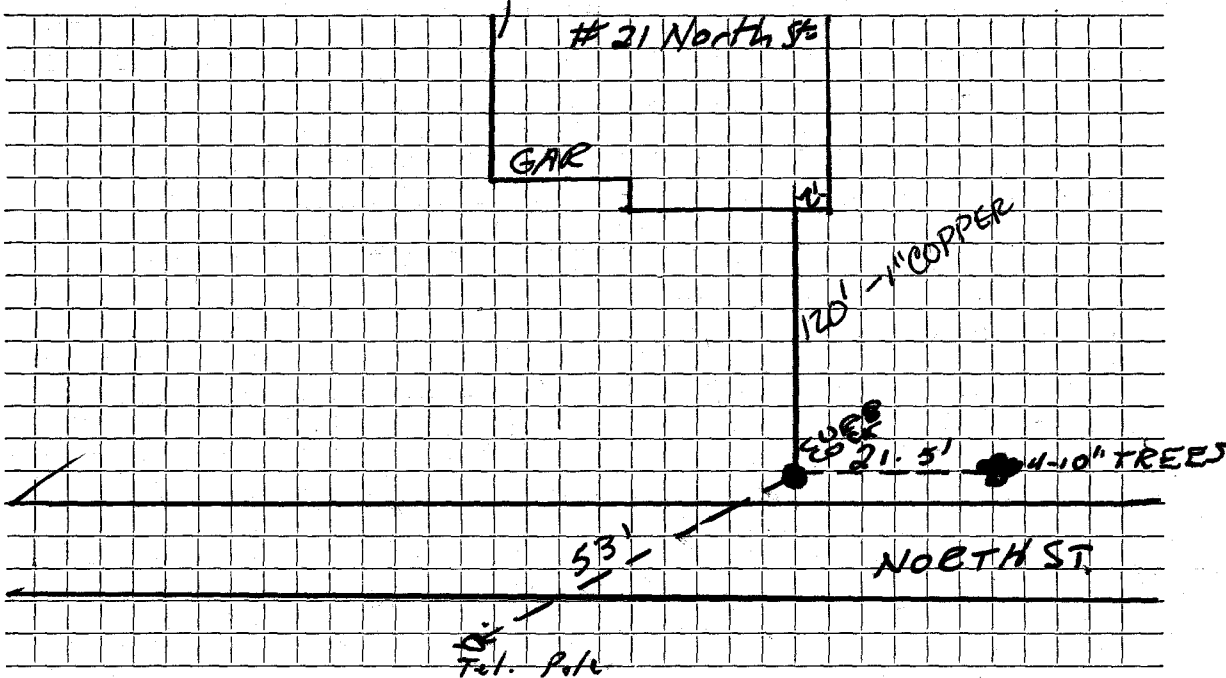

Connection made in ~~7th St~~ ~~8th St~~ Street.

Work completed .. 6/16/76

Remarks: NORTH
.....
.....