

Name Burton Harrison

Service No.

127 #4315

Address 29 North Street

Lexington, Mass.

Location 29 North Street

Kind of Pipe

Size

Size of Main

~~REPAIR~~ ~~RENEWAL~~ New Service

Com. 9-26-49

Location

Date	Material	Amount	Total	Date	Amount
Jul. 13, '49	Labor	44 70	44 70	July 12 '49	2 00 00
	10% Overhead		4 47	Oct 6 '49	42 15
	186' - 3/4" Copper Tubing @.24	44 64			157 85
	1 - 3/4" C x 1/2" I.W.H. S&W	3 29		Jul. 14, '49	20 40
	Shovel 5 hrs. @ 7.00	35 00		22' - 3/4" Copper Tubing @.24	5 28
	D4 Tractor 2 hrs. @ 3.00	6 00		1 - 3/4" C Corp-cock	3 15
	Trailer 1 hr. @ 3.00	3 00		1 - 3/4" C x 3/4" C Curb-cock	3 85
	Trucking 1 hr. @ .75	75		2 - 3/4" C x 3/4" I Unions 2 pts.	1 76
	Patching 16 x 3	16 00		1 - Box & Rod	3 95
			157 85	1 - Pit Cover & Frame	8 65
				Shovel 2 hrs. @ 7.00	14 00
				Trucking 1 hr. @ .75	75
	Labor				61 78

DATE _____

TOWN OF LEXINGTON – BOARD OF PUBLIC WORKS

WATER DIVISION

The undersigned applies for a supply of water at No..... St. and hereby agrees to comply with the rules and regulations as now, or at any future time, established by the Board of Selectmen.

Am't of Estimate \$.....

Owner


Am't Paid \$.....

Address

Builder

.....

Sketch of Service Here

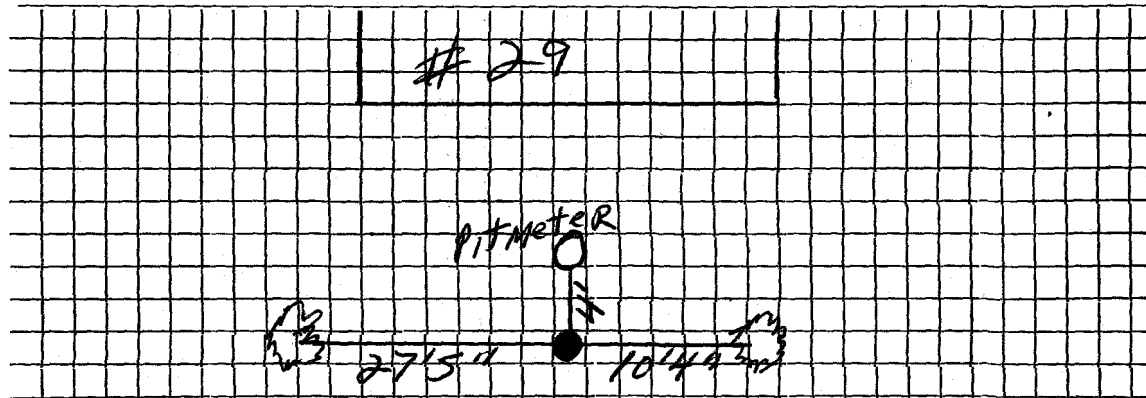

Connection made in Street.

Work completed19

Remarks: