

Name John V. Harrington

Service No.

251 443

Address 3 North Street

Lexington, Mass.

Location 3 North Street

Kind of Pipe

Size

Size of Main

~~XXXXXXXXXX~~ - New Service

Com. 12-31-49

Location

Date	Material	Amount	Total	Date	Amount
Dec. 17, '49	Labor	2 55	2 55	Dec. 17, '49	60 00
	10% Overhead		26	Dec. 21, '49	4 52
	76' - 3/4" Copper Tubing @ .24	18 24	24		55 48
	1 - 3/4" C x 1/2" I.W.H. S&W	3 29	29	Dec. 17, '49	12 75
	1 - 3/4" C x 3/4" C Union (3pts)	1 39	39	30' - 3/4" Copper Tubing @ .24	7 20
	Littlefield Shovel 1 hr. @ 7.00	7 00	7 00	1 - 3/4" C Core-cock	3 15
	Trucking 1 hr. @ .75		75	1 - 3/4" C x 3/4" C Curb-cock	3 85
	Patching 22 x 3		22 00	1 - Box & Rod	3 75
			55 48	1 - 1/2" Offset Tail Piece	37
				1 - 1/2" Straight Tail Piece	37
				Littlefield Shovel 3 hrs. @ 7.00	21 00
				Trucking 1 hr. @ .75	75
	Labor				53 19

DATE \_\_\_\_\_

TOWN OF LEXINGTON – BOARD OF PUBLIC WORKS

**WATER DIVISION**

The undersigned applies for a supply of water at No..... St. and hereby agrees to comply with the rules and regulations as now, or at any future time, established by the Board of Selectmen.

Am't of Estimate \$.....

Owner .....


Am't Paid \$.....

Address .....

Builder .....

.....

Sketch of Service Here

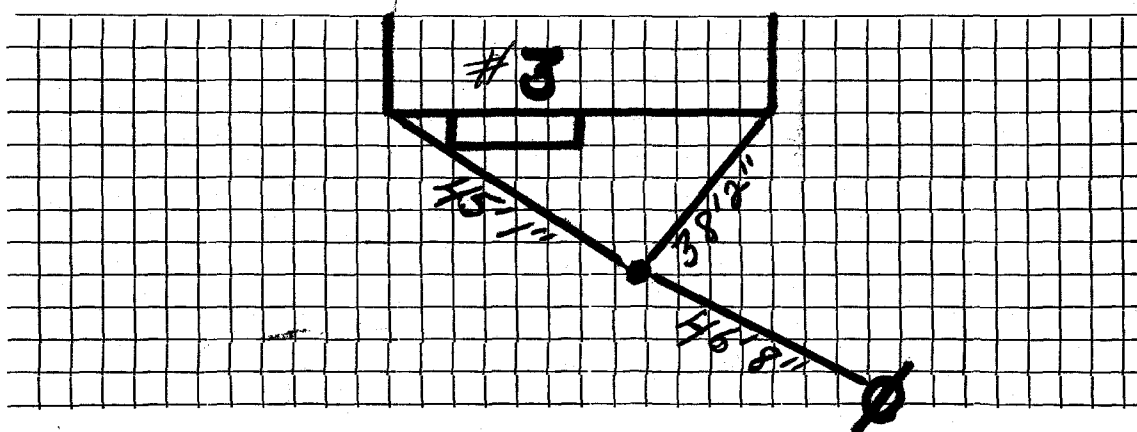

Connection made in ..... Street.

Work completed .....19

Remarks: