

WATER SERVICE RECORD

Name Benjamin Franklin Homes, Inc.

Service No. #79

Address ^{NORTH}
358 Emerson Road

Location

~~Repair~~ New Service W.O. #7368

Comm 10-29-62


Date	Material	Amount	Total	Date	Amount	
8-6-62	Labor	12.12		6-29-62	Deposit	25.00
6-23-62	"	4.26	17.38	10-29-62	ReFund	8.18
	10% O.H.	1.74	19.12			41.77
86'	3/4" Copper Tubing @.42		36.12			
1	3/4" CX 1/2 I.W.H. Stop & Waste		6.17		NON CHARGE	
1	3/4" C3 Part Union		2.41	6-6-62	Labor	6.20
1	Hr. Trucking @3.00		3.00	44'	3/4" Copper tubing @.42	18.48
			66.82	1	3/4" C Corp Cock	4.91
				1	3/4" C Curb Cock	6.28
				1	Box & Rod	4.90
				1	1/2 Straight Tailpiece	.50
				1	1/2 Offset Tailpiece	.50
						41.77

DATE _____

TOWN OF LEXINGTON — BOARD OF PUBLIC WORKS

WATER DIVISION

Sketch of Service Here

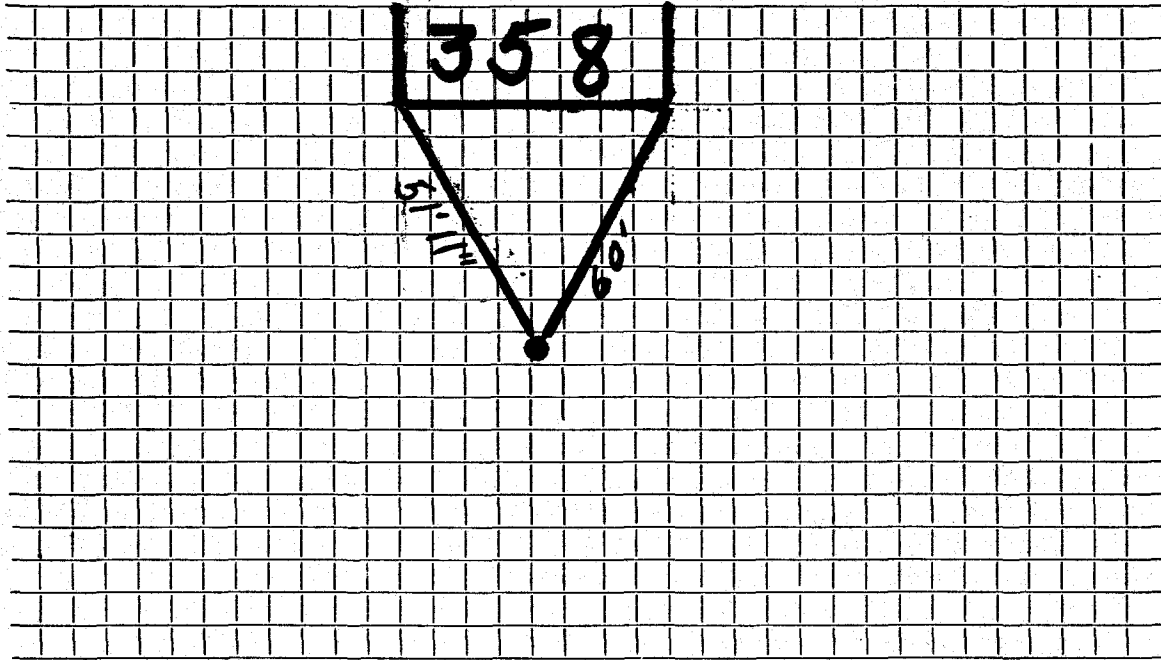

Connection made in Street. Work completed

Remarks:

.....

.....