

#5200

**WATER SERVICE RECORD**

Name Benjamin Franklin Homes

**Service No.**

77

**Address** 359 *NORTH* Emerson Road

**Location** Lot 31 Sta. 9+11


~~Richard Stevens~~—New Service Richard Stevens Permit #418

DEC 31 1965

DATE \_\_\_\_\_

TOWN OF LEXINGTON — BOARD OF PUBLIC WORKS  
WATER DIVISION

Sketch of Service Here

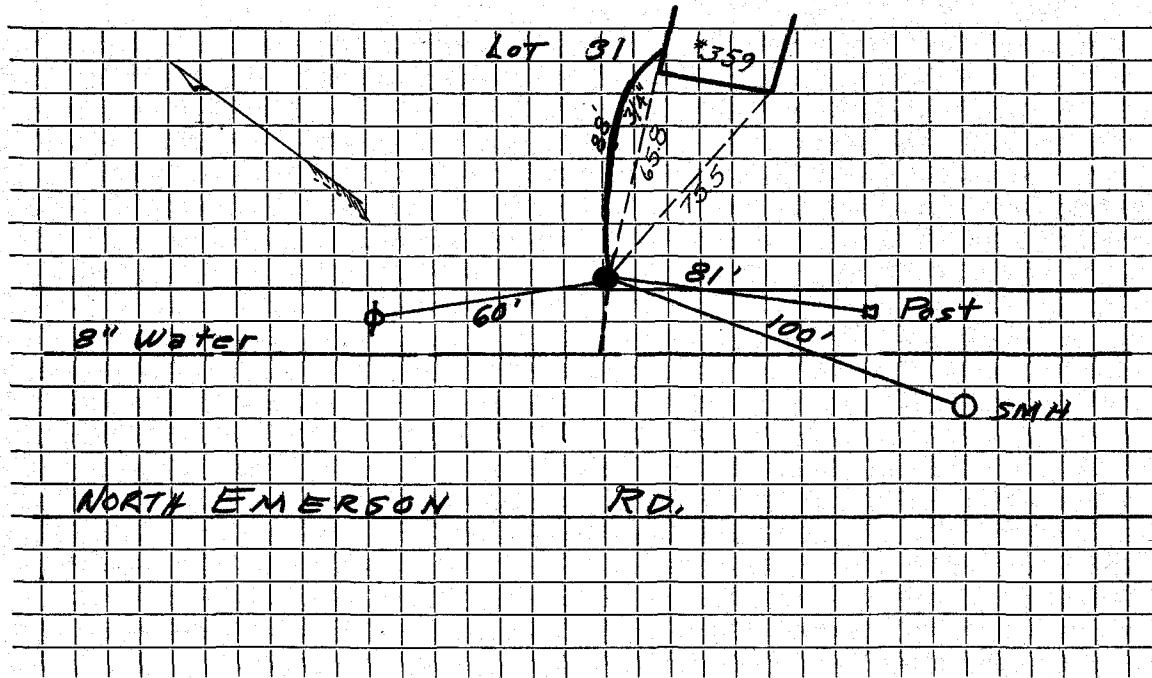

Connection made in ..... Street. Work completed .....

Remarks: .....

.....