

WATER SERVICE RECORD

181

Name Kenneth Cox

Service No. 179

Address 36 North Street,

Location Lexington

2106
6999

~~Repair-Remove~~ New Service

Com. 9-29-52


| Date | Material | Amount | Total | Date | Amount |
|--------|------------------------------------|--------|-------|-------------------------------|-------------------|
| 9/8/52 | Labor | 2 85 | | 8-20-52 | 40 00 |
| | 10% Overhead | 29 | 3 14 | 9-29-52 | 12 97 |
| | 21' - 3/4" Copper tubing@.34 | | 7 14 | | <u>NON CHARGE</u> |
| | 1 - 3/4" C x 1/2 I.W.H. stop&waste | | 4 00 | 9/8/52 | Labor |
| | 1 hr. Littlefield shovel | | 7 00 | | 2 85 |
| | 1 hr. trucking | | 75 | 10' - 3/4" Copper tubing@.34 | 3 40 |
| | patching 5 X 3 | | 5 00 | 1 - 3/4" C Corp-cock | 4 33 |
| | | | 27 03 | 1 - 3/4" C x 3/4" C curb-cock | 4 67 |
| | | | | 1 box and rod | 3 90 |
| | | | | 1 - 1/2 offset tail piece | 50 |
| | | | | 1 - 1/2 straight tail piece | 50 |
| | | | | 1 hr. Littlefield shovel | 7 00 |
| | | | | 1 hr. trucking | 75 |
| | | | | | <u>27 90</u> |

DATE _____

TOWN OF LEXINGTON — BOARD OF PUBLIC WORKS

WATER DIVISION

Sketch of Service Here

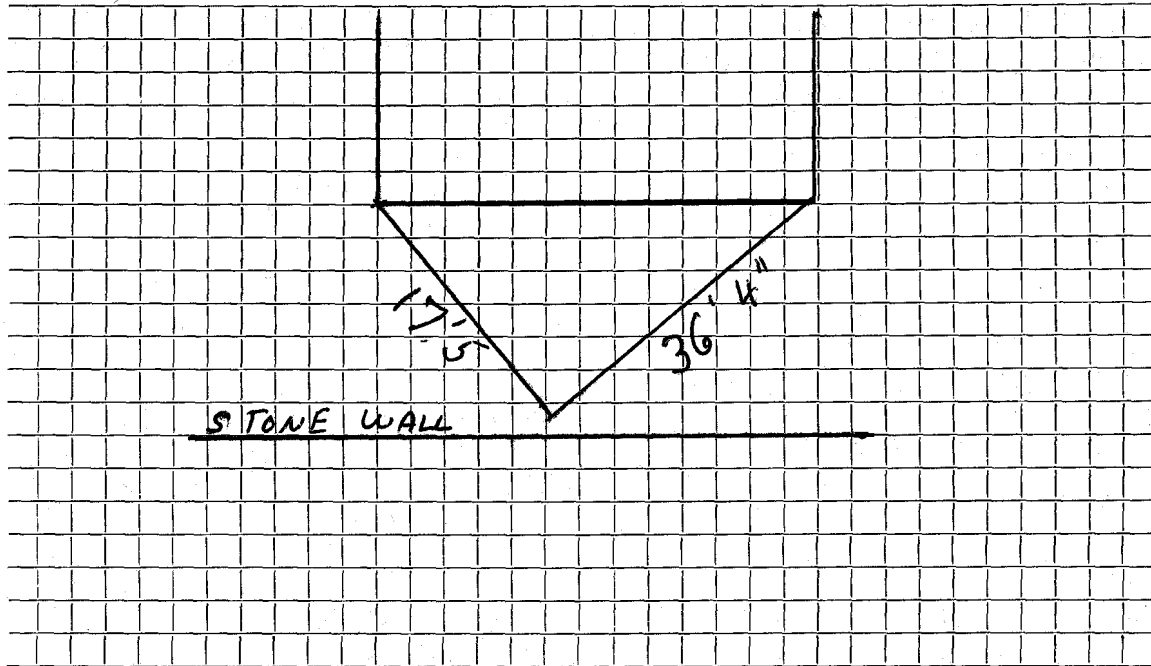

Connection made in Street. Work completed

Remarks:
.....
.....