




DATE \_\_\_\_\_

TOWN OF LEXINGTON — BOARD OF PUBLIC WORKS

WATER DIVISION

Sketch of Service Here

Water Ser. for #361  
NORTH Emerson Rd.

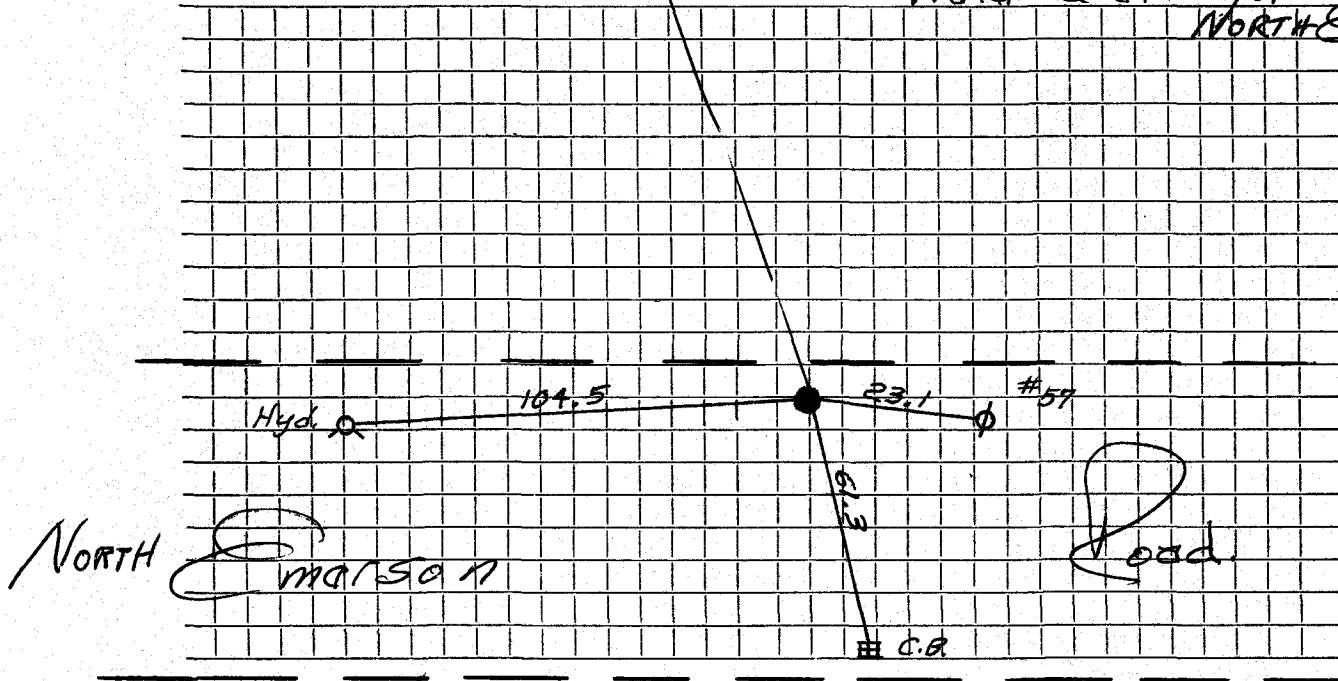

Connection made in ..... Street. Work completed .....

Remarks: .....

.....

.....