

8749

WATER SERVICE RECORD

4367

Name Benjamin Franklin Homes

Service No. 81

Address ^{NORTH} 362 Emerson Road

Location Lot #38

~~RENEWAL~~ - New Service W.O. #7370

Comm 10-29-62


Date	Material	Amount	Total	Date		Amount
8-6-62	Labor	2.13		6-19-62	Deposit	75.00
	10% O.H.	.21	2.34	10-29-62	* Resund	12.18
1	3/4" C x 1/2 I.W.H. Stop & Waste		<u>6.17</u>			62.82
	BILL WHEN CONNECTED		8.51			
7-3-62	Labor	4.54			NON CHARGE	
	10% O.H.	.45	4.99	8-6-62	Labor	12.79
97'	3/4" Copper tubing @.42		40.74	49'	3/4" Copper tubing @.42	18.48
1	3/4" C part union		2.41	1	3/4" C Curb Cock	6.28
1	3/4" C x 1/2 I.W.H. Stop & Waste		<u>6.17</u>	1	Box & Rod	4.90
			62.82	1	3/4" C Corp Cock	<u>4.91</u>
				1	1/2 Straight tailpiece	47.30
				1	1/2 Offset tailpiece	50
						48.36

* Applied to 54489

DATE _____

TOWN OF LEXINGTON — BOARD OF PUBLIC WORKS
WATER DIVISION

Sketch of Service Here

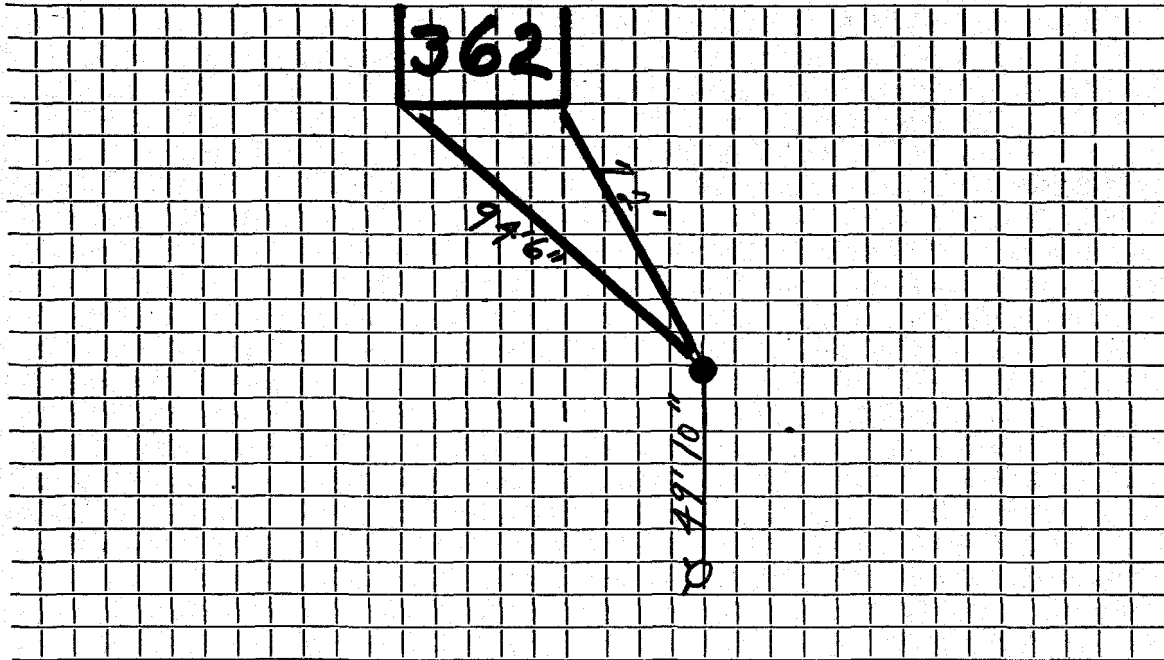

Connection made in Street. Work completed

Remarks:

.....

.....