




DATE *5.3.89*

TOWN OF LEXINGTON — BOARD OF PUBLIC WORKS

**WATER DIVISION**

Sketch of Service Here

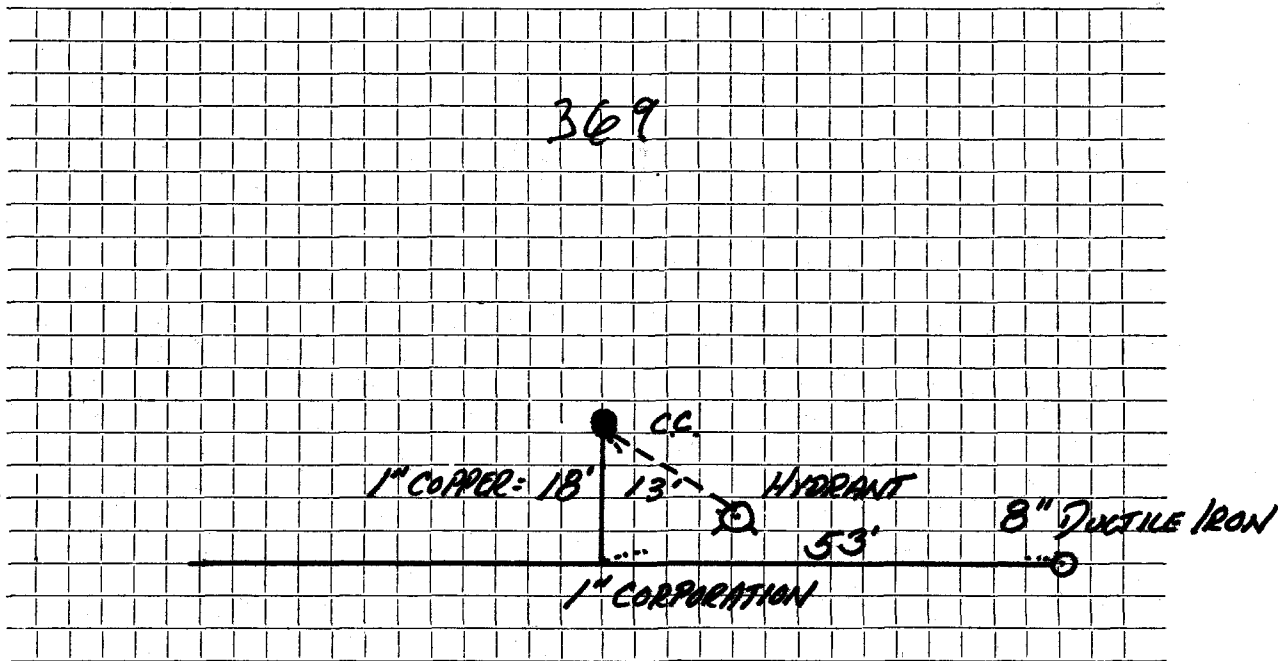

Connection made in *NORTH EMERSON ROAD* Street.

Work completed .....

Remarks: .....

.....

.....