

DATE 5-3-89


TOWN OF LEXINGTON — BOARD OF PUBLIC WORKS

WATER DIVISION

371

Sketch of Service Here

Lot 14

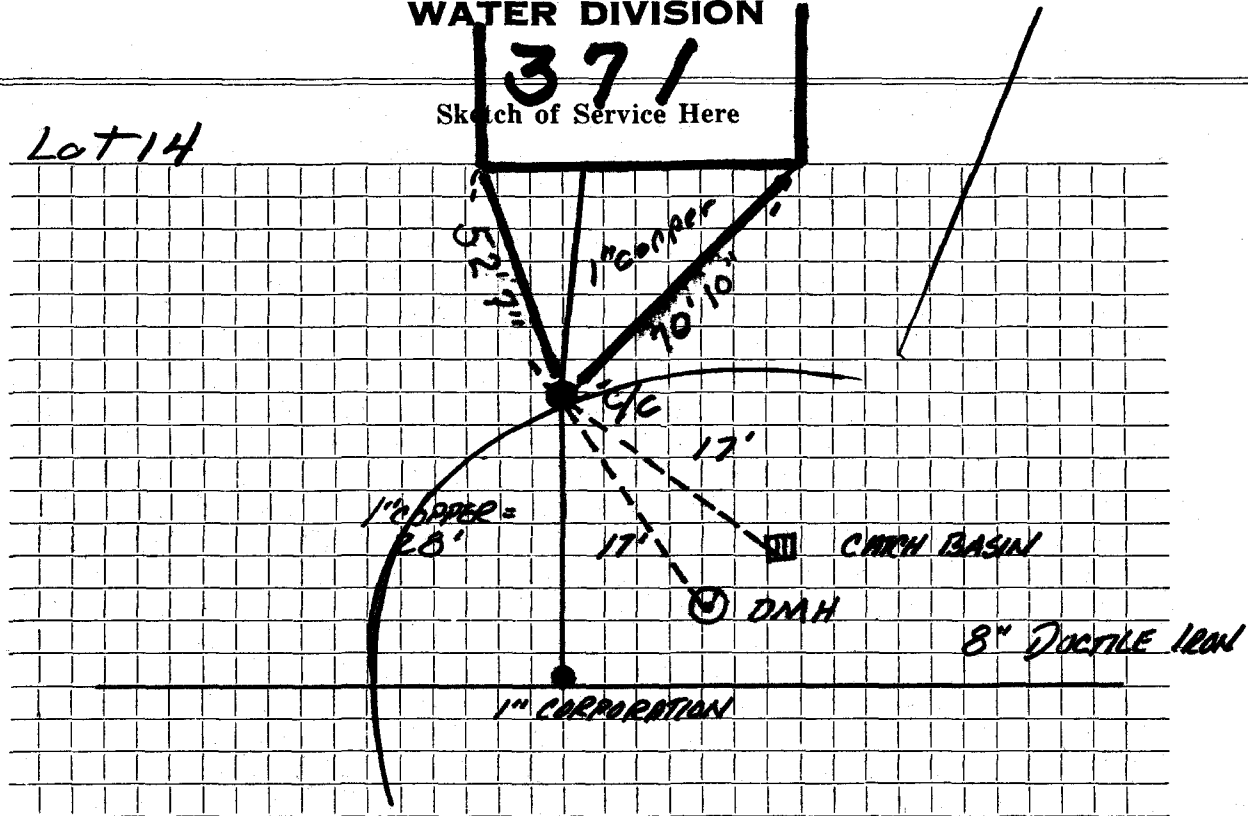

Connection made in 371 NORTH EMERSON RD. Street.

Work completed

Remarks: