

WATER SERVICE RECORD

#140
81

Name Benjamin Gott

Service No.

Address 38 North Street

Location Lexington, Mass.

~~Repair - Renewal~~ - New Service


Com. 8-6-51

Date	Material	Amount	Total	Date	Amount
5-17-51	Labor	10 00	10 00	May 8 '51	35 00
	10% Overhead		1 00	<i>Deposited</i>	
	145' - 3/4" Copper Tubing @.326	14 67		<i>Paid</i>	(12 42)
	1 - 3/4" x 1/2" I.W.H. S&W	1 00		NoCharge	47 42
	Littlefield Shovel 2 hrs. @ 7.00	14 00		5-17-51 Labor	69 97
	Trucking 1 hr. @.75	75		15' - 3/4" Copper Tubing @.326	4 89
	Patching 3 x 3	3 00		1 - 3/4" Corp-cock	4 33
		47 42		1 - 3/4" x 3/4" Curb-cock	4 67
				1 - Box & Rod	4 68
				1 - 1/2" Offset Tail Piece	50
				1 - 1/2" Straight Tail Piece	50
				Dynamite 3 lbs. @.24	72
				Exploders 5 @.147	74
				Compressor 2 hrs. @ 1.75	3 50
				Littlefield Shovel 3 hrs. @7.00	21 00
				Trucking 1 hr. @.75	75
					116 25
				<i>Bill sent 8-6-51</i>	

DATE _____

TOWN OF LEXINGTON — BOARD OF PUBLIC WORKS
WATER DIVISION

Sketch of Service Here
38 NORTH ST

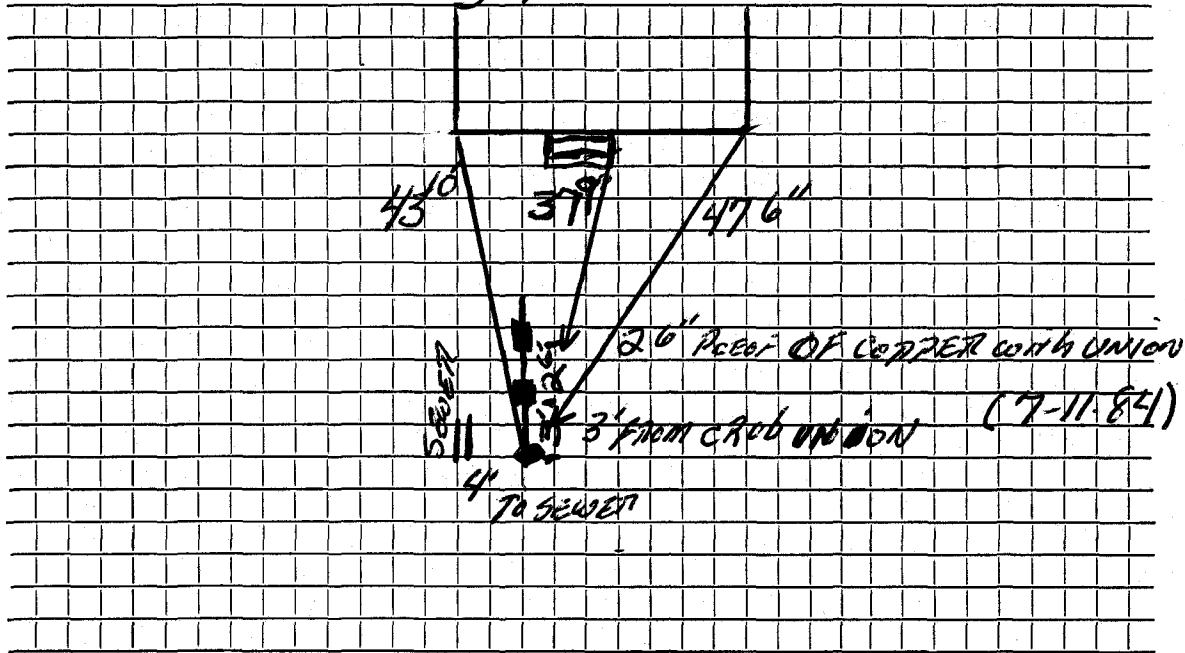

Connection made in Street. Work completed

Remarks:

.....
.....