

Name Warren Carver

Service No. 192 ^{#3455}

Address 44 North Street

Lexington, Mass.

Location 44 North Street

Kind of Pipe

Size

Size of Main

~~Repair~~ ~~Renewal~~ New Service

Com. 11-6-50

Location

Date

Material

Amount

Total

Date

Amount

Aug. 8, 50

Labor

3 45

3 45

July 28 '50

Depleted

6000

10% Overhead

35

52' - 3/4" Copper Tubing @.275

14 30

No Charge

4714

1 - 3/4" C x 1/2" I.W.H. S&W

3 29

Aug. 8, 50 Labor

3 45

Littlefield Shovel 3 hrs. @

7.00 21 00

7' - 3/4" Copper Tubing @.275

1 93

Trucking 1 hr. @.75

75

1 - 3/4" C Corp-cock

3 15

Patching 4 x 3

4 00

1 - 3/4" C x 3/4" C Curb-cock

3 85

47 14

1 - Box & Rod

3 35

1 - 1/2" Offset Tail Piece

42

1 - 1/2" Straight Tail Piece

42

Littlefield Shovel 1 hr. @.7.00

7 00

Trucking 1 hr. @.75

75

Labor

24 32

DATE _____

TOWN OF LEXINGTON—BOARD OF PUBLIC WORKS

WATER DIVISION

The undersigned applies for a supply of water at No. _____ St. and hereby agrees to comply with the rules and regulations as now, or at any future time, established by the Board of Selectmen.

Am't. of Estimate \$ _____


Owner _____

Am't. Paid \$ _____

Address _____

Builder _____

Sketch of Service Here

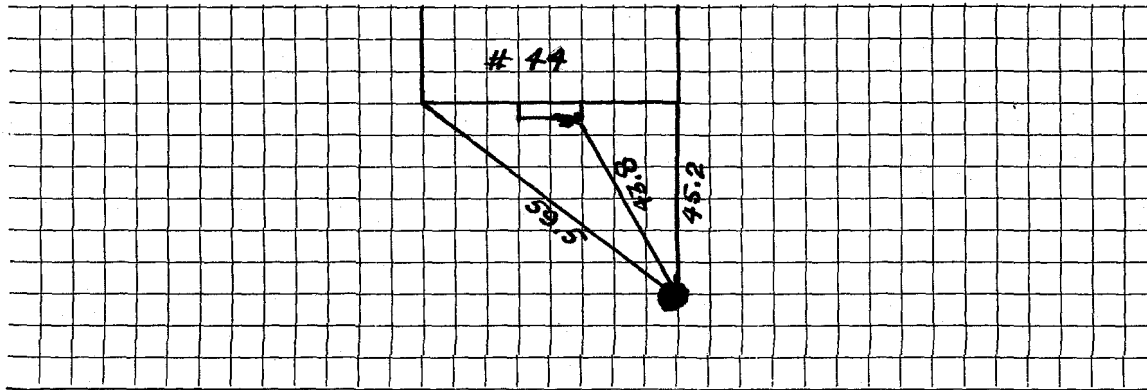

Connection made in _____ Street.

Work completed _____ 19

Remarks: