

WATER SERVICE RECORD

Name The Windmere Group

Service No.

Address 47 NORTH ST.

Location

Repair—Renewal—New Service McLaughlin #0379


Date	Material	Amount	Total	Date		Amount
9/22/94	64 LF 1" COPPER					
				7-5-49		
					22' 3/4" Copper	
					1 3/4" C. Corp Cock	
					1 3/4" C. X 3/4" C. Curb Cock	
					1 3/4" C. X 3/4" C. UNION	

DATE 9/22/94

TOWN OF LEXINGTON — BOARD OF PUBLIC WORKS

WATER DIVISION

Sketch of Service Here

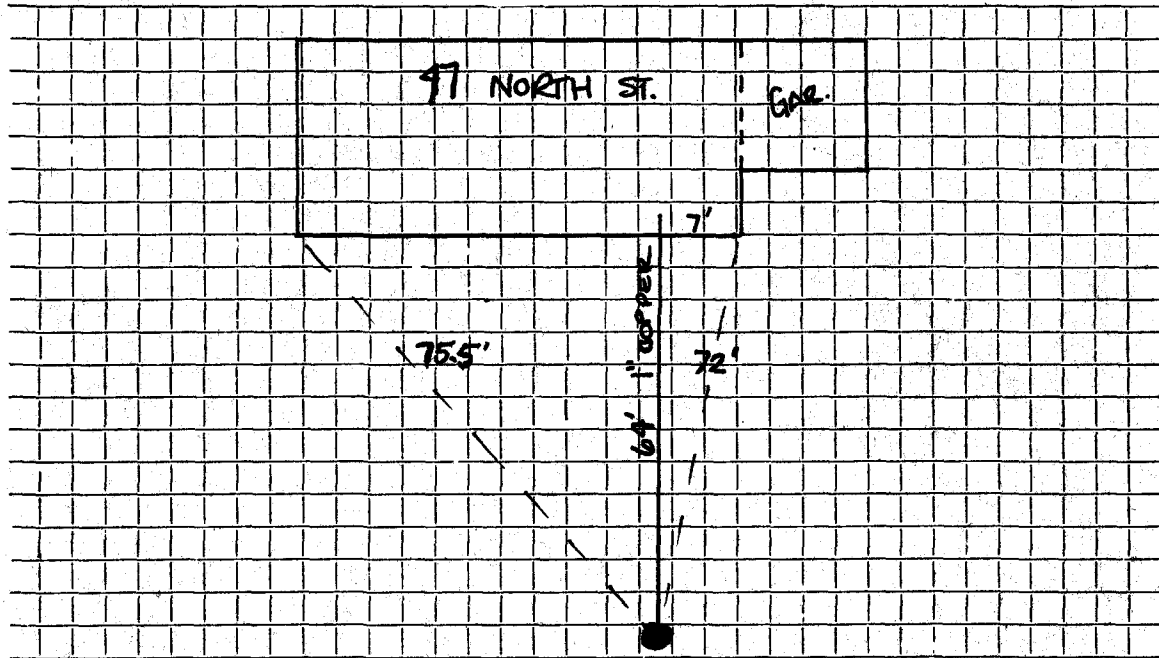

Connection made in Street. Work completed

Remarks: Original Service 7-5-49