

Name Francis Napoli

Service No. 214

Address 5 North Street

#798

Lexington, Mass.

Location 5 North Street

#7236, 7428

Kind of Pipe

Size

Size of Main

~~Remove~~ ~~Remove~~ New Service

Com. 11-8-49

Location

Date	Material	Amount	Total	Date	Amount
Oct. 17, '49	Labor	1 35	1 35	Oct 10 '49	60 00
	10% Overhead		14	Nov 17 '49	33 08
	1 - 3/4" C x 1/8" I.W.H. S&W		3 29		No Charge
	1 - 3/4" C x 3/4" C Union (3pts)		1 39	Oct. 12, '49	Labor
	Trucking 1 hr. @.75		75	28' - 3/4" Copper Tubing @.24	6 72
	Patching 20 - 3		20 00	1 - 3/4" C Corp-cock	3 15
			26 92	1 - 3/4" C x 3/4" C Curb-cock	3 85
	Pipe supplied by owner			1 - Box & Rod	2 75
				1 - 1/2" Offset Tail Piece	37
				1 - 1/2" Straight Tail Piece	37
				Littlefield Shovel 2 1/2 hrs. @7.00	17 50
				Trucking 1 hr. @.75	75
	Labor				43 96

DATE \_\_\_\_\_

TOWN OF LEXINGTON - BOARD OF PUBLIC WORKS

**WATER DIVISION**

The undersigned applies for a supply of water at No..... St. and hereby agrees to comply with the rules and regulations as now, or at any future time, established by the Board of Selectmen.

Am't of Estimate \$.....

Owner .....


Am't Paid \$.....

Address .....

Builder .....

.....

Sketch of Service Here

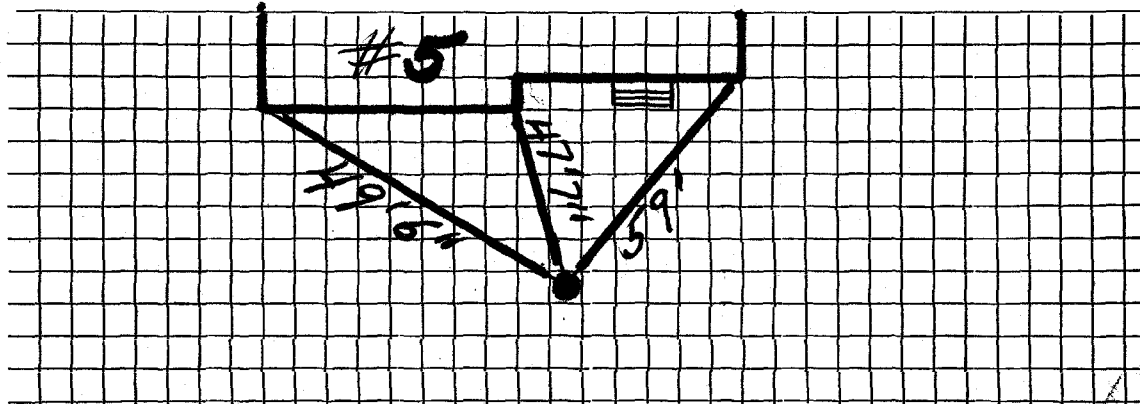

Connection made in ..... Street.

Work completed .....19

Remarks: