

## WATER SERVICE RECORD

Name Hall &amp; Company

Service No. 14

Address 50 North Street

Location

~~Repair Work~~—New Service

W.O. #5547

AUG 29 1977


Date		Material	Amount	Total	Date	Amount	
6/29/77		labor	124. 46		6/27/77	Deposit	150. 00
		10%OH	12. 44	136. 90	7/1/77		
	16'	1" copper @ .83		13. 28			
	1	1" corporation		16. 69			
	1	1" curb		20. 54			
	1	box & rod		13. 41			
	½	ton cold patch		3. 31			
	3	hrs. shovel @ 6.50		19. 50			
	1	hr. compressor		5. 00			
	1	hr. trucking @ 3.00		3. 00			
		Hot Top 5' X 7'		23. 24			
				254. 87			
8/12/77	68'	1" copper					

DATE \_\_\_\_\_

TOWN OF LEXINGTON — BOARD OF PUBLIC WORKS

**WATER DIVISION**

Sketch of Service Here

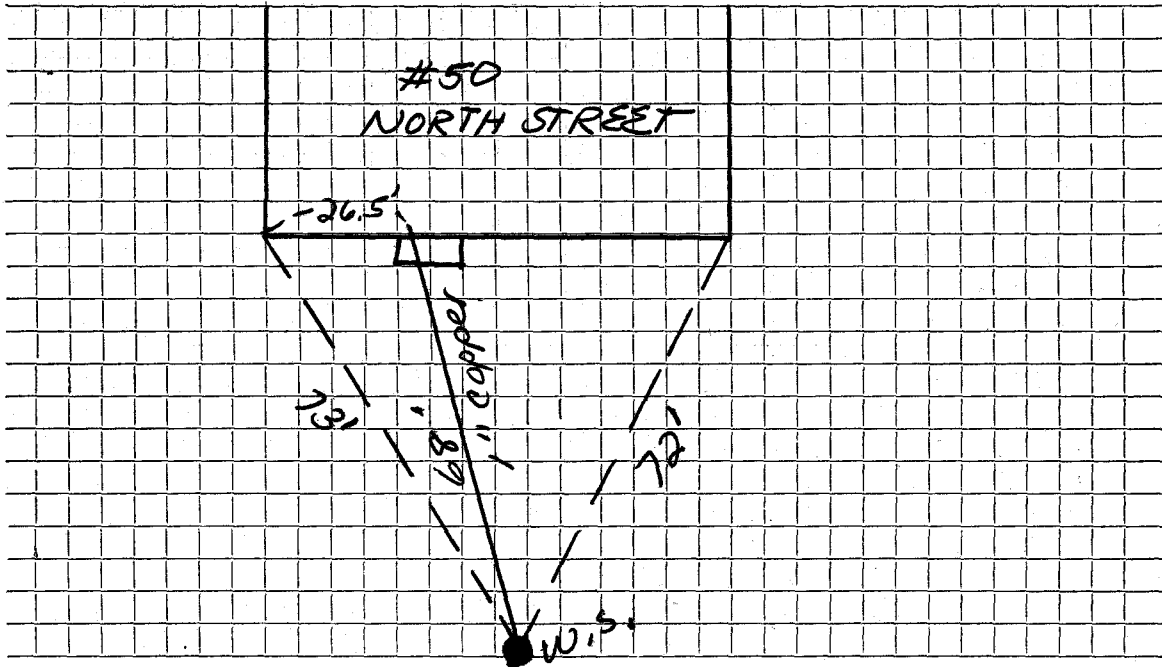

Connection made in ..... Street.      Work completed .....

Remarks: .....  
.....  
.....