

WATER SERVICE RECORD

Name Charles Price

Service No. 40

Address 52 North St.

Location

~~NEW SERVICE~~ New Service W.O. 5851 Eagle #3053

DEC 18 1977


Date		Material	Amount		Total	Date	Amount
11/16/77		Labor	119	75		11-17-77	130 00
		10% O.H.	11	97	131 72	1-17-78	117 41
	19'	1" Copper @ 1.08			20 52		247 41
	1	1" Corp			16 69		
	1	1" Curb			20 54		
	1	Box & Rod			13 41		
	½	Ton Cold Patch			3 37		
		Hot Top 7' x 4'			18 66		
	1	Hr. Trucking			3 00		
	3	Hrs. Backhoe			19 50		
					<u>247 41</u>		
2/2/77	84½'	1" Copper					

DATE _____

TOWN OF LEXINGTON — BOARD OF PUBLIC WORKS

WATER DIVISION

Sketch of Service Here

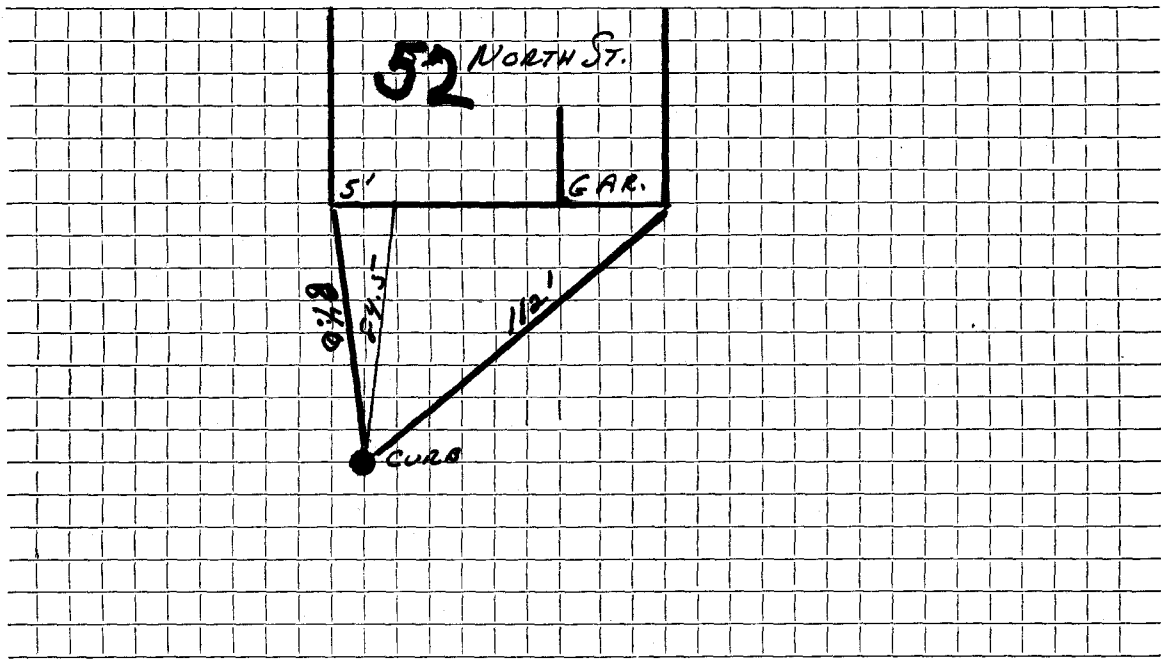

Connection made in Street. Work completed

Remarks:
.....
.....