

# WATER SERVICE RECORD

Name Wayne LaValle

Service No. 10

Address 54 North Street

Location

~~REPAIR & RENEWAL~~ - New Service W.O. #6263 Brian Kelly #3079


SEP 25 1978

Date	Material	Amount	Total	Date		Amount
6-7-78	Labor	43.62		5-4-78	DEPOSIT	130.00
	10% O.H.	4.36	47.98	11-21-78	PAID	33.63
13'	1" Copper tubing @.90		11.70		IN	142.63
1	1" Corp		17.86	68'	1" COPPER	
1	1" Curb		21.98		1- VALVE	
1	Box & Rod		11.00			
1/2	ton Cold Patch		7.37			
1	hr. Trucking		3.00			
1 1/2	hr. Backhoe		9.75			
	Hot Top 6' x 8'		31.98			
			162.62			

DATE \_\_\_\_\_

# TOWN OF LEXINGTON — BOARD OF PUBLIC WORKS

## WATER DIVISION

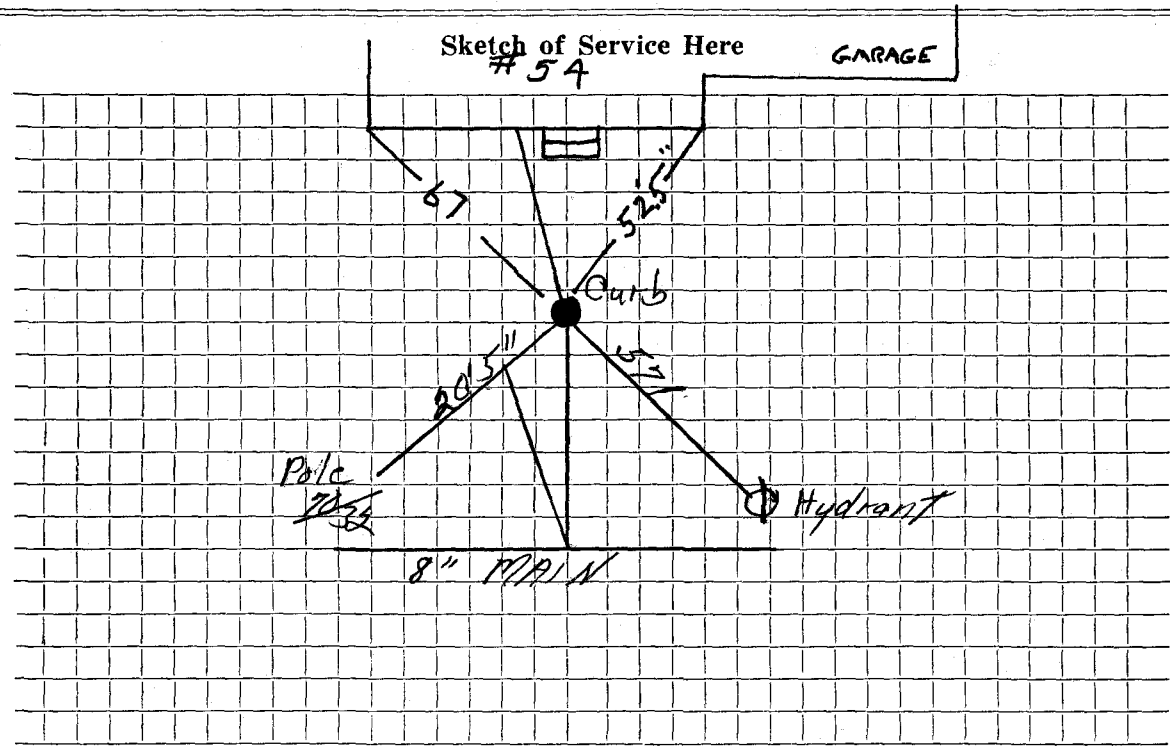


Connection made in ..... Street. Work completed .....

Remarks: .....  
.....  
.....



TOWN OF LEXINGTON — BOARD OF PUBLIC WORKS

WATER DIVISION

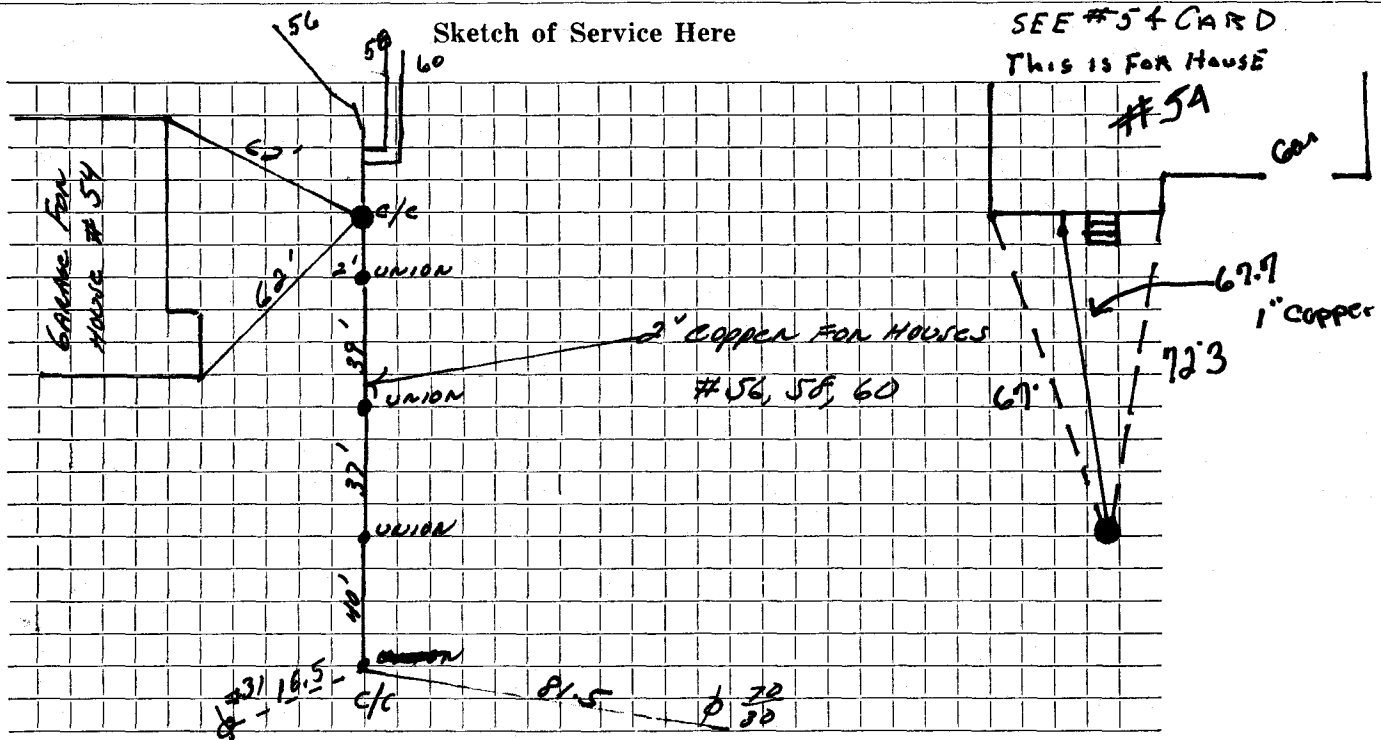

Connection made in ..... Street. Work completed .....

Remarks: 56-58-60 off 2" COPPER .....

.....  
.....