


TOWN OF LEXINGTON — BOARD OF PUBLIC WORKS

WATER DIVISION

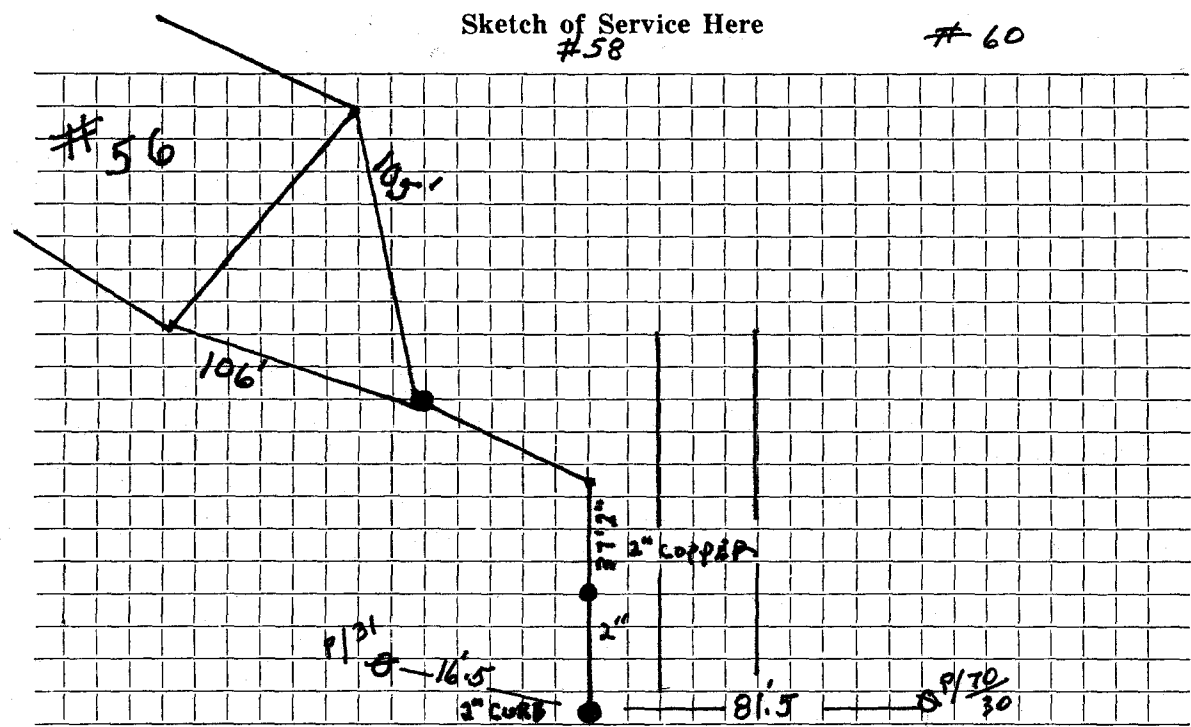

Connection made in Street. Work completed

Remarks: 56 - 58 - 60 ALL OFF 2" COPPER line

.....
.....