


DATE 6/30/92

TOWN OF LEXINGTON — BOARD OF PUBLIC WORKS

WATER DIVISION

Sketch of Service Here

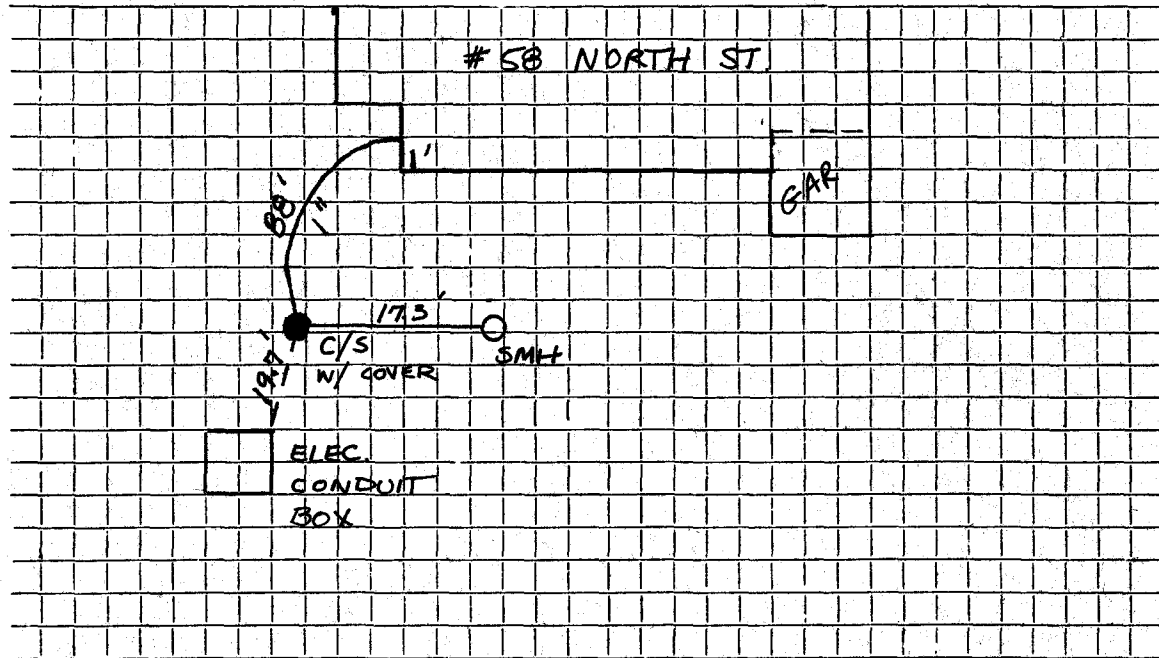

Connection made in NORTH Street. Work completed

Remarks: INSTALLED BY: J. MCLAUGHLIN

INSPECTED BY: CRG