

Name Irene Revais

Service No. 45

#6210

Address 6 North Street

Lexington, Mass.

Location 6 North Street

Kind of Pipe

Size

Size of Main

~~Repairs-Repairs~~ New Service

Com. 5-29-50

Location

Date	Material	Amount	Total	Date	Amount
Apr. 7, '50	Labor	1 30	1 30	April 4 '50	20 00
	10% Overhead		13	Apr 8 '50	1 65
	56' - 3/4" Copper Tubing @.23	12 88	12 88		No Charge
	1 - 3/4" C x 1/2" I.W.H. S&W	3 29	3 29	Apr. 7, '50	Labor
	Trucking 1 hr. @.75		75	8' - 3/4" Copper Tubing @.23	1 84
			18 35	1 - 3/4" Corp-cock	3 15
				1 - 3/4" C x 3/4" Curb-cock	3 85
				1 - Box & Rod	3 60
				1 - 1/2" Offset Tail Piece	38
				1 - 1/2" Straight Tail Piece	38
				Trucking 1 hr. @.75	75
					28 28
	Labor				

DATE \_\_\_\_\_

TOWN OF LEXINGTON – BOARD OF PUBLIC WORKS

**WATER DIVISION**

The undersigned applies for a supply of water at No..... St. and hereby agrees to comply with the rules and regulations as now, or at any future time, established by the Board of Selectmen.

Am't of Estimate \$.....

Owner .....


Am't Paid \$.....

Address .....

Builder .....

.....

Sketch of Service Here

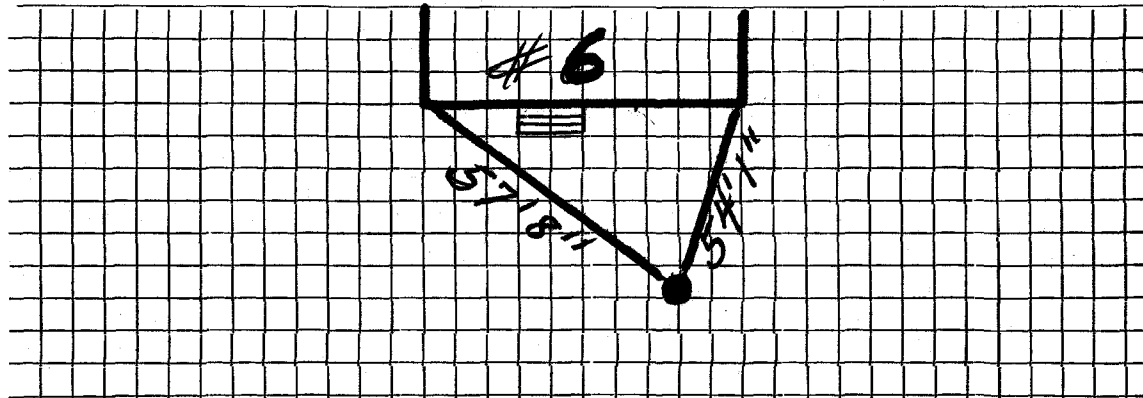

Connection made in ..... Street.

Work completed .....19

Remarks: