

WATER SERVICE RECORD

#4417 #4420

Name Vincent E. Hayes

Service No. 332

Address 7 North Street

Location Lexington, Mass.

~~XXXXXXXXXXXX~~ Repair ~~XXXXXXXXXXXX~~ Renewal New Service


Com. 12-26-50

Date	Material	Amount	Total	Date	Material	Amount
Nov. 14, '50	Labor	5 00	5 00	Oct. 24 '50	Deposited	75 00
	10% Overhead		50			
	50' - 3/4" Copper Tubing @.32	16 00			No Charge	65 01
	1 - 3/4" x 1/2" I.W.H. S&W	3 76		Nov. 14, '50	Labor	6 67
	Littlefield Shovel 3 hrs. @7.00	21 00			27' - 3/4" Copper Tubing @.32	8 64
	Trucking 1 hr. @.75	75			1 - 3/4" Corp-cock	3 60
	Patching 18 x 3	18 00			1 - 3/4" C x 3/4" Curb-cock	4 40
		65 01			1 - Box & Rod	3 35
					1 - 1/2" Offset Tail Piece	42
					1 - 1/2" Straight Tail Piece	42
					Littlefield Shovel 2 hrs. @7.00	14 00
					Trucking 1 hr. @.75	75
						42 25

DATE \_\_\_\_\_

TOWN OF LEXINGTON — BOARD OF PUBLIC WORKS  
WATER DIVISION

Sketch of Service Here

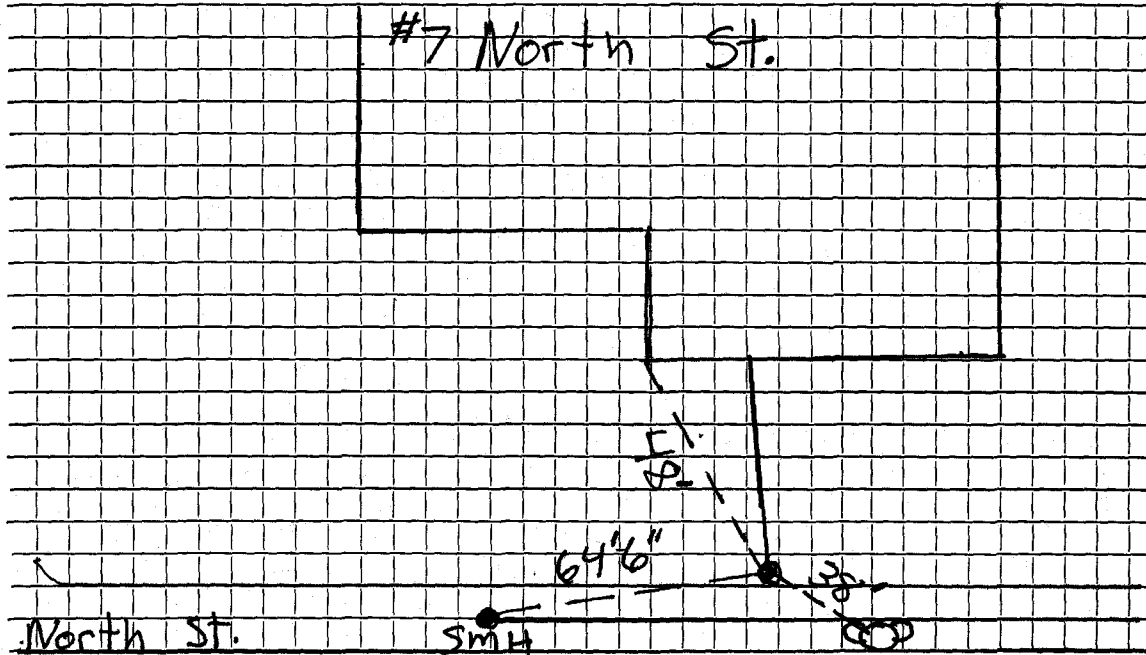

Connection made in ..... Street. Work completed .....

Remarks: .....

.....  
.....