

**WATER SERVICE RECORD**

Name *S and A Realty Trust*

Service No. *8*

Address *70 North Street*

Location

**AUG 6 1979**

~~Repair - General~~ **New Service** *Arlex Const.* **W.O. #0373**


Date		Material	Amount	Total	Date	Amount
7/6/79	100'	3/4 Copper			4-24-79	195 00
6/18/79		Labor	55.59		8/1/79	65 62
		10% O.H.	5.56	61.15		129 38
	16'	3/4 Copper @ .74		11.84		
	1	3/4 Curb		16.12		
	1	3/4 Corp		17.27		
	1	Box & Rod		13.50		
	1	Hr. Trucking		3.00		
	1	Hr. Backhoe		6.50		
				129.38		
7-6-79	100'	3/4" Copper tubing				

DATE \_\_\_\_\_

# TOWN OF LEXINGTON — BOARD OF PUBLIC WORKS

## WATER DIVISION

Sketch of Service Here

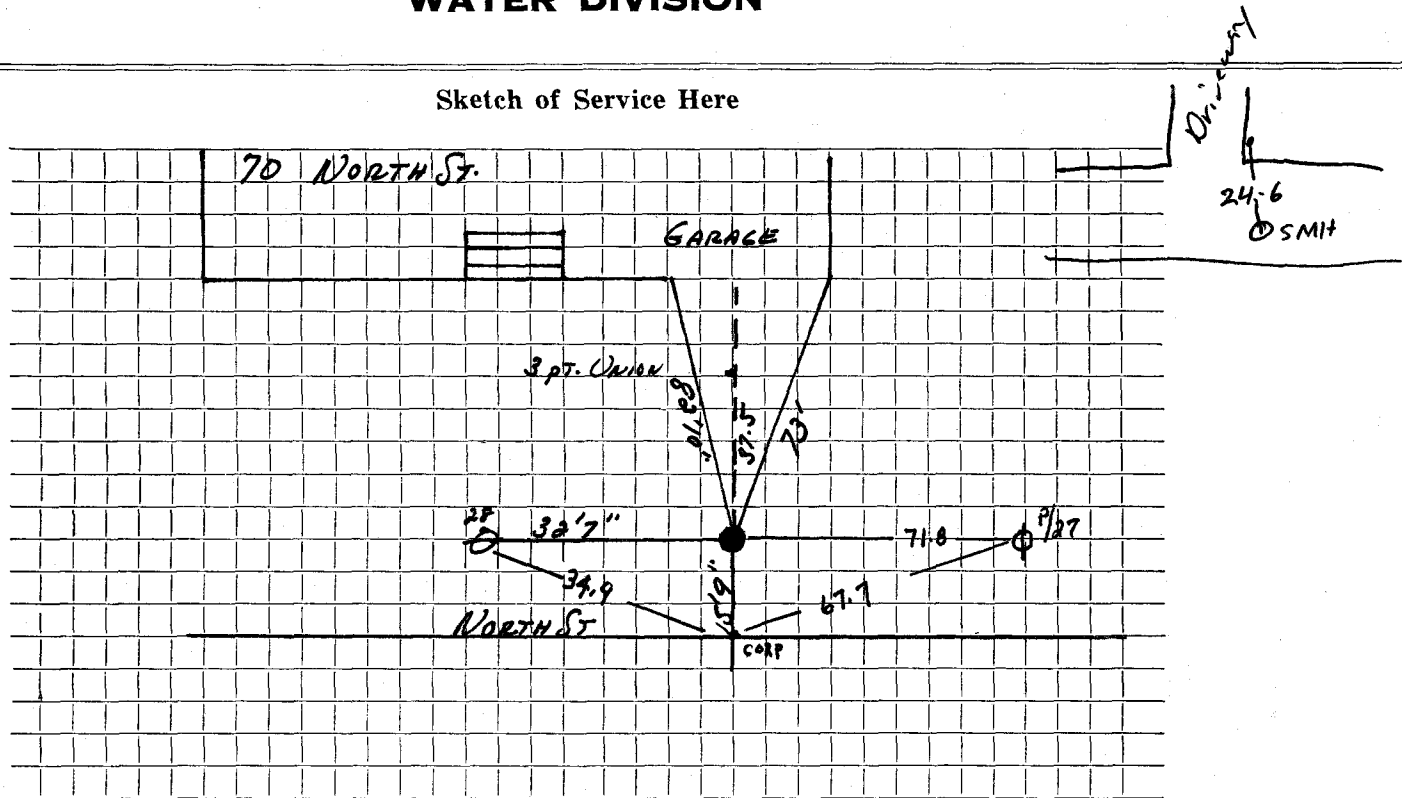

Connection made in ..... Street. Work completed .....

Remarks: .....  
.....  
.....