

WATER SERVICE RECORD

Name Jenkins Realty

Service No. 79

Address 74 North Street

Location

~~Repair/Reconnect~~ New Service

W. O. # 286

DeFlice #2183


FEB 12 1973

Date	Material	Amount	Total	Date	Amount
11/28/72	Labor	47 97		11/6/72	150 00
	10% O.H.	4 80	52 77	2/12/73	36 78
14'	3/4" Copper pipe	.79	11 06		<u>113 22</u>
1	3/4" Corporation		9 57		
1	3/4" Curb Cock		11 32		
	Box & Rod		7 50		
1/2	Ton cold patch	8.00	2 00		
2	Hrs. Trucking	3.00	6 00		
2	Hrs. Shovel	6.50	13 00		
			<u>113 22</u>		
11/30/72	67' 3/4" Copper				

DATE _____

TOWN OF LEXINGTON — BOARD OF PUBLIC WORKS
WATER DIVISION

Sketch of Service Here

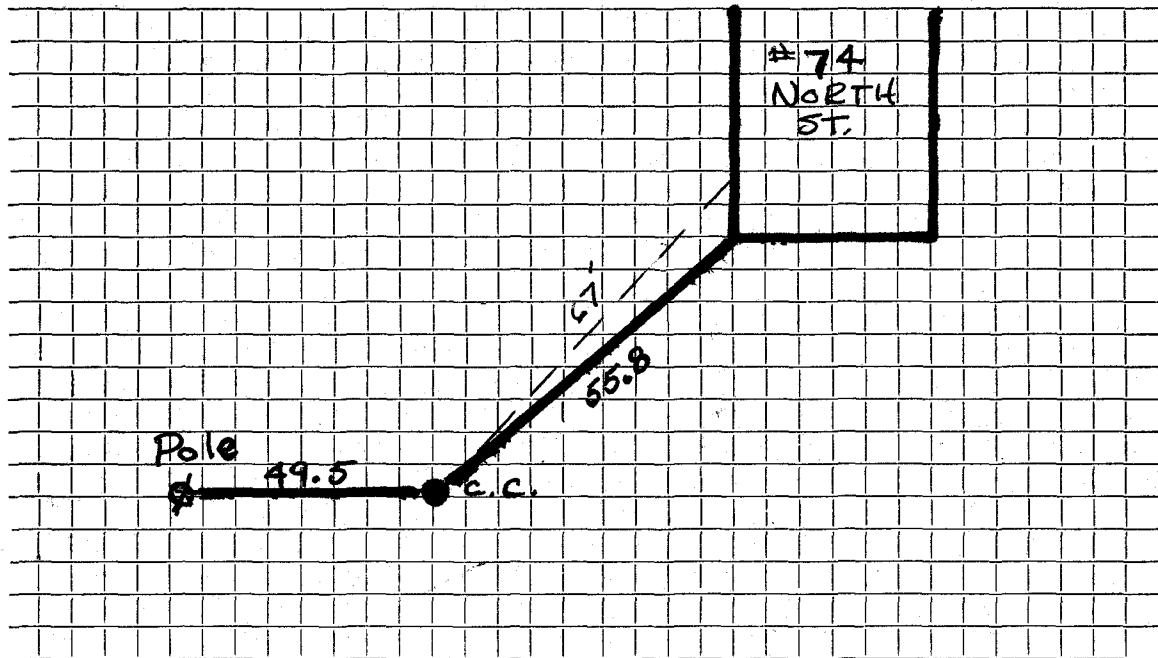

Connection made in Street. Work completed

Remarks:
.....
.....