

WATER SERVICE RECORD

Name *S and A Realty Trust*

Service No. *16*

Address *78 North Street*

Location

~~Repair - Renewal~~ - New Service *Arlex Const.* W.O. #0479


AUG 6 1979

Date		Material	Amount		Total		Date	Amount	
<i>7/6/79</i>	<i>100'</i>	<i>3/4 Copper</i>					<i>6-6-79</i>	<i>Deposit</i>	<i>150 00</i>
<i>6/18/79</i>		<i>Labor</i>	<i>55.</i>	<i>59</i>			<i>8-2-79</i>	<i>Refund</i>	<i>22 84</i>
		<i>10% O.H.</i>	<i>5.</i>	<i>56</i>	<i>61.</i>	<i>15</i>			<i>127 16</i>
	<i>13'</i>	<i>3/4 Copper @ .74</i>			<i>9.</i>	<i>62</i>			
	<i>1</i>	<i>3/4 Curb</i>			<i>16.</i>	<i>12</i>			
	<i>1</i>	<i>3/4 Corp</i>			<i>17.</i>	<i>27</i>			
	<i>1</i>	<i>Box & Rod</i>			<i>13.</i>	<i>50</i>			
	<i>1</i>	<i>Hr. Trucking</i>			<i>3.</i>	<i>00</i>			
	<i>1</i>	<i>Hr. Backhoe</i>			<i>6.</i>	<i>50</i>			
					<u><i>127.</i></u>	<u><i>16</i></u>			
<i>7/6/79</i>	<i>100'</i>	<i>3/4" Copper Tubing</i>							

TOWN OF LEXINGTON — BOARD OF PUBLIC WORKS

WATER DIVISION

Sketch of Service Here

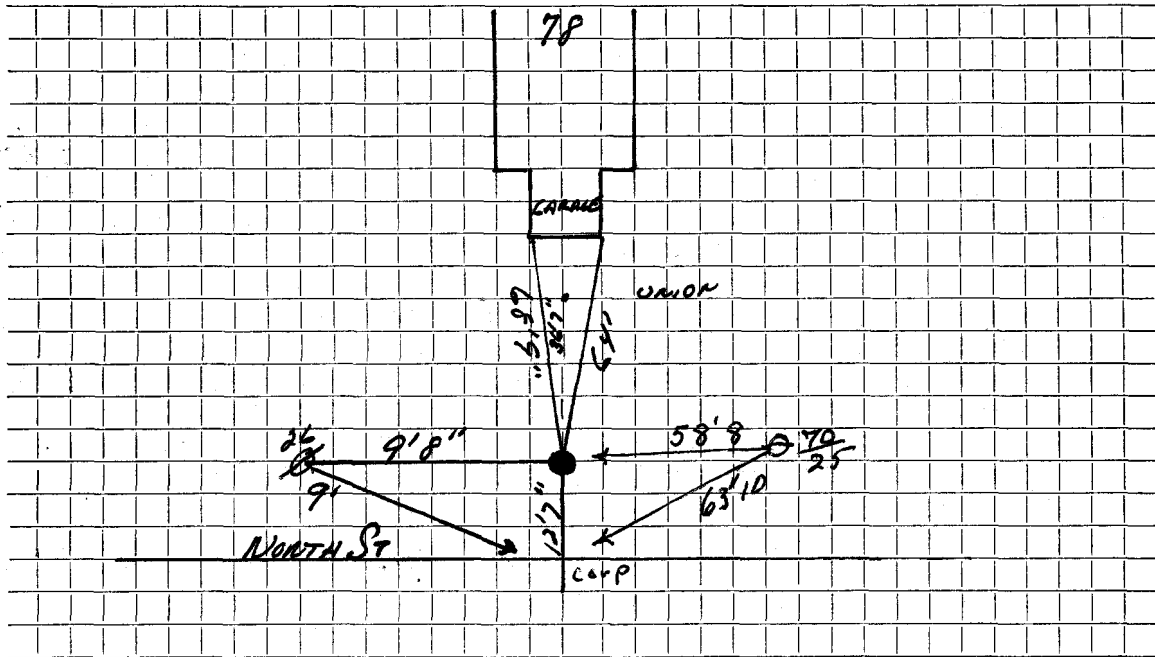

Connection made in Street. Work completed

Remarks:
.....
.....