

Name William Selfridge

Service No. 105 3204

Address 82 North Street

# 3177

Lexington, Mass.

Location 82 North Street

Kind of Pipe

Size

Size of Main

~~Repair~~ ~~Renewal~~ - New Service

Com 12-30-46

Location

Date	Material	Amount	Total	Date	Material	Amount
Nov. 9, '46	Labor	23 40	23 40	Nov. 9, '46	Labor	6 73
	10% Overhead		2 34		6' - 3/4" Copper Tubing @.24	1 44
	41' - 3/4" Copper Tubing @.24		9 84		1 - 3/4" C Corp-cock	2 70
	1 - 3/4" C x 1/2" I.W.H. S & W		2 82		1 - 3/4" C x 3/4" C Curb-cock	3 30
	Patching 2 x 3		2 00		1 - Box % & Rod	3 50
	Trucking 1 hr. @.75		75		1 - 1/2" Straight Tail Piece	50
			41 15		1 - 1/2" Offset Tail Piece	50
					Trucking 1 hr. @.75	75
	Labor					19 42

*Reported  
Paid  
Non-Charge*

Hadley Press, Inc., Lexington

# TOWN OF LEXINGTON—BOARD OF PUBLIC WORKS

## WATER DIVISION

The undersigned applies for a supply of water at No. \_\_\_\_\_ St. and hereby agrees to comply with the rules and regulations as now, or at any future time, established by the Board of Selectmen.


Am't. of Estimate \$ \_\_\_\_\_

Owner \_\_\_\_\_

Am't. Paid \$ \_\_\_\_\_

Address \_\_\_\_\_

Builder \_\_\_\_\_

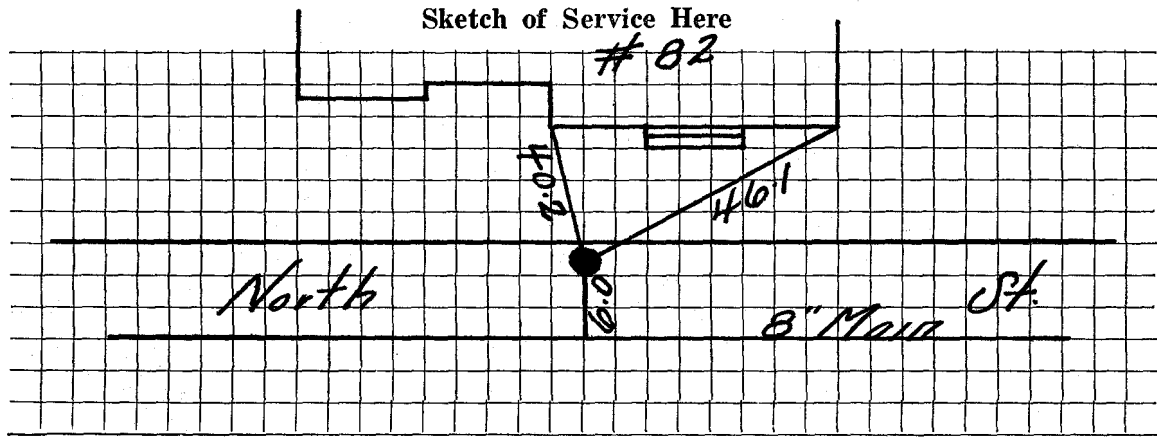

Connection made in \_\_\_\_\_ Street.

Work completed \_\_\_\_\_ 19

Remarks: