

Name William Selfridge

Service No. 72 3176

Address 84 North Street

Lexington, Mass.

Location 84 North Street

Kind of Pipe

Size

Size of Main

Repair—Renewal—New Service

Location

Date	Material	Amount	Total	Date	Location	Amount
Aug. 24, '46	Labor	2 46		Aug 9 '46	Deposited	40 00
Aug. 26, '46	"	<u>10 39</u>	12 85	Nov. 29 '46	Refunded	<u>2 32</u>
	10% Overhead		1 29		Non-Chagre	37 68
	43' - $\frac{3}{4}$ " Copper Tubing @ .1911		8 22	Aug. 24, '46	Labor	2 66
	1 - $\frac{3}{4}$ " C x $\frac{1}{2}$ " I.W.H. Stop & Waste		2 82	Aug. 26, '46	"	1 80
	Gas Shovel 1 hr.		7 00	5' - $\frac{3}{4}$ " Copper Tubing @ .1911		96
	Compressor hr. (1)		1 75	1 - $\frac{3}{4}$ " C Corp-cock		2 70
	Patching 3 x 3		3 00	1 - $\frac{3}{4}$ " C x 3" C Curb-cock		3 30
	Trucking 1 hr. @ .75		<u>75</u>	1 - Box & Rod		1 65
			37 68	1 - $\frac{1}{2}$ " Straight Tail Piece		90
				1 - $\frac{1}{2}$ " Offset Tail Piece		90
				Trucking 1 hr. @ .75		<u>75</u>
	Labor					15 62

DATE \_\_\_\_\_

# TOWN OF LEXINGTON—BOARD OF PUBLIC WORKS

## WATER DIVISION

The undersigned applies for a supply of water at No. \_\_\_\_\_ St. and hereby agrees to comply with the rules and regulations as now, or at any future time, established by the Board of Selectmen.

Am't. of Estimate \$ \_\_\_\_\_


Owner \_\_\_\_\_

Am't. Paid \$ 200

Address \_\_\_\_\_

Builder \_\_\_\_\_

Sketch of Service Here

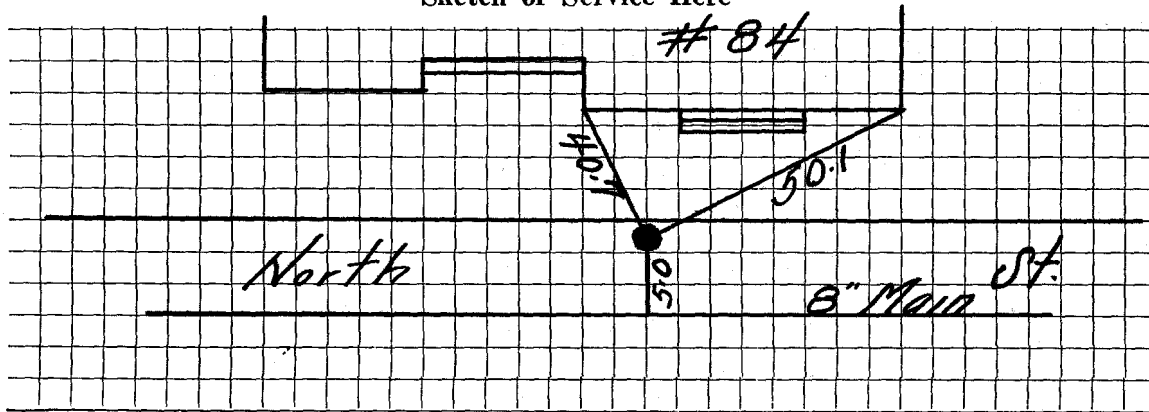

Connection made in \_\_\_\_\_ Street.

Work completed \_\_\_\_\_ 19

Remarks: