

# WATER SERVICE RECORD

Name Henry J. Moulton

Service No. 113

Address 85 North Street

Location Lexington, Mass.

~~Repair-Renewal~~ New Service


Com. 8-6-51

Date	Material	Amount.	Total	Date	Material	Amount
6-7-51	Labor	1 49	1 49	June 1. 51	Deposited	60 00
	10% Overhead		15			
	60¢ - 3/4" Copper Tubing @.326	19 56	19 56		No Charge	
	1 - 3/4"C x 1/2" I.W.H. S&W	4 00	4 00	6-7-51	Labor	5 13
	Littlefield Shovel 1 hr. @7.00	7 00	7 00	2 1/2' - 3/4" Copper Tubing @.326		7 82
	Trucking 1 hr. @.75		75	1 - 3/4" C Corp-cock		4 33
	Patching 18 x 3		18 00	1 - 3/4"C x 3/4"C Curb-cock		4 67
			50 95	1 - Box & Rod		4 68
				1 - 1/2" Offset Tail Piece		50
				1 - 1/8" Straight Tail Piece		50
				Littlefield Shovel 1 hr. @ 7.00		7 00
				Trucking 1 hr. @.75		75
						35 38

DATE \_\_\_\_\_

TOWN OF LEXINGTON — BOARD OF PUBLIC WORKS  
WATER DIVISION

Sketch of Service Here

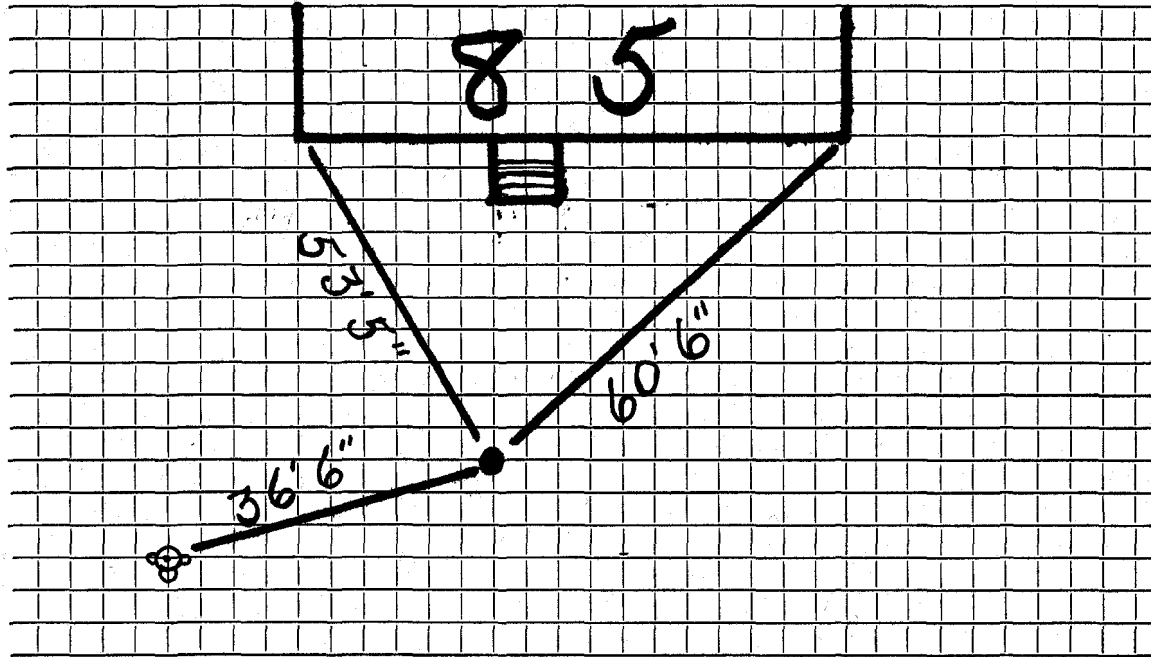

Connection made in ..... Street. Work completed .....

Remarks: .....

.....  
.....