

Name William Selfridge

Service No. 43 3177

Address 86 North Street

# 2734

Lexington, Mass.

Location 88 North Street

Kind of Pipe

Size

Size of Main

Repair—Renewal—New Service

Location

Date	Material	Amount	Total	Date	Amount	
Aug. 24, '46	Labor	2 46		Aug 12, '46	40 00	
Aug. 26, '46	"	10 39	12 85	Nov 29, '46	1 37	
	10% Overhead		1 29		38 63	
	48' - $\frac{3}{4}$ " Copper Tubing @.1911		9 17	Aug. 24, '46	Labor	2 72
	1 - $\frac{3}{4}$ " C x $\frac{1}{2}$ " I.W.H. Stop & Waste		2 82	Aug. 26, '46	"	1 80
	Gas Shovel 1 hr. @.7.00		7 00	5' - $\frac{3}{4}$ " Copper Tubing		96
	Compressor 1 hr.		1 75	1 - $\frac{3}{4}$ " C. Corp-cock		2 70
	Patching 3 x 3		3 00	1 - $\frac{3}{4}$ " C x $\frac{3}{4}$ " C Curb-cock		3 30
	Trucking 1 hr.		75	1 - Box & Rod		1 65
			38 63	1 - $\frac{1}{2}$ " Straight Tail Piece		90
				1 - $\frac{1}{2}$ " Offset Tail Piece		90
				Trucking 1 hr. @.75		75
	Labor				15 68	

DATE \_\_\_\_\_

# TOWN OF LEXINGTON—BOARD OF PUBLIC WORKS

## WATER DIVISION

The undersigned applies for a supply of water at No. \_\_\_\_\_ St. and hereby agrees to comply with the rules and regulations as now, or at any future time, established by the Board of Selectmen.


Am't. of Estimate \$ \_\_\_\_\_

Owner \_\_\_\_\_

Am't. Paid \$ \_\_\_\_\_

Address \_\_\_\_\_

Builder \_\_\_\_\_

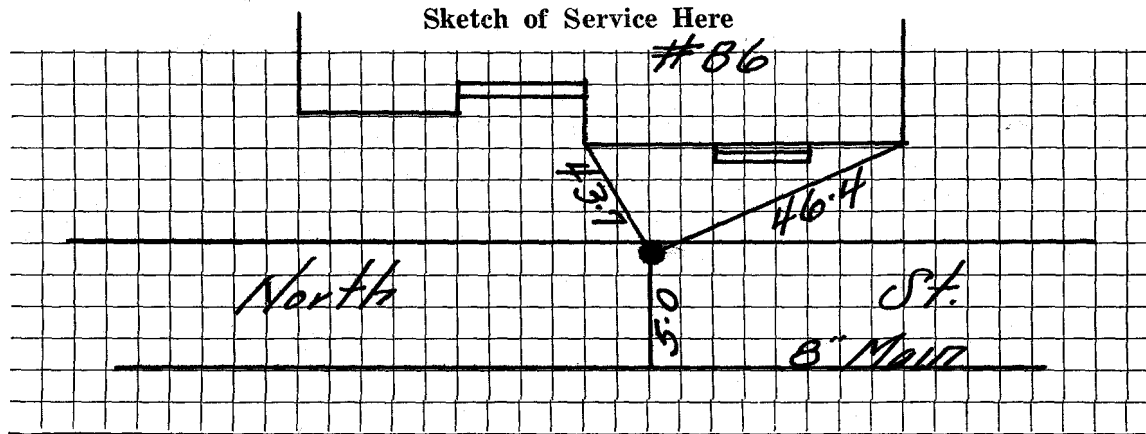

Connection made in \_\_\_\_\_ Street.

Work completed \_\_\_\_\_ 19

Remarks: