


**Water Service Tie Card**  
**TOWN OF LEXINGTON**

**87 North St**

MASSACHUSETTS

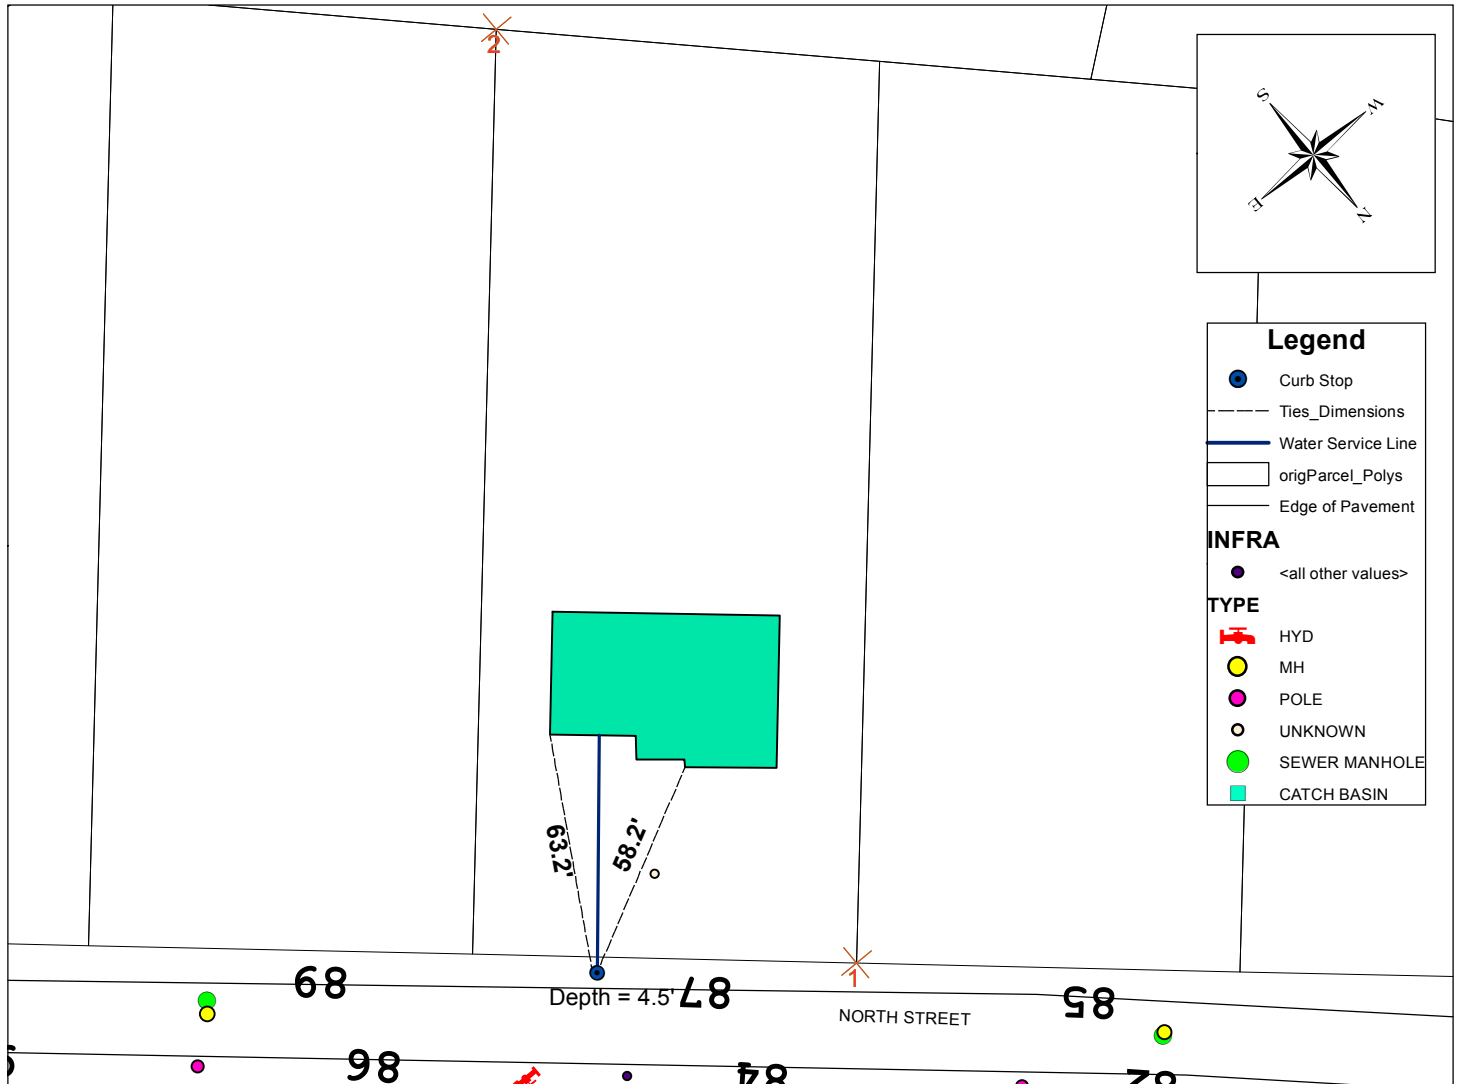

Address	Map and Lot	Permit Number	Contractor Name	Inspector
87 North St	76-6	7050	Express Excavation	mweisman
Date	Material	Depth of Cover	Amount	
12/7/2016	3/4" copper	4.5 ft	0.5'	
	3/4" to 1" increaser	4.5 ft	1	
	1" Copper type "k"	4.5 ft	.5'	
	1" Curb Valve and Buffalo Box	4.5 ft	1	
	1" Copper type "k"	4.5 ft	62'	
Type of work completed				

New 1" water service to house from curb stop. New house on lot old house removed.