

Name James Clark

Service No. 1943732

Address 89 North Street

Lexington, Mass.

Location 89 North Street

Kind of Pipe

Size

Size of Main

~~XXXXXXXXXX~~ New Service

Com. 9-26-49

Location

Date	Material	Amount	Total	Date	Amount
Aug. 30, '49	Labor	2 50	2 50	Aug 23 '49	35 00
	10% Overhead		25		
	58' - 3/4" Copper Tubing @ .24	13 92			No Charge
	1 - 3/4" C x 1/2" I.W.H. S&W	3 15			1 - 1/8" Offset Tail Piece 37
	1 - 3/4" C x 3/4" C Union (3pts)	1 39			1 - 1/2" Straight Tail Piece 37
	Littlefield Shovel 2 hrs. @ 7.00	14 00			74
	Trucking 1 hr. @ .75		75		
			35 96		Service was in to curb - Old garden service
	Labor				

DATE _____

TOWN OF LEXINGTON - BOARD OF PUBLIC WORKS

WATER DIVISION

The undersigned applies for a supply of water at No..... St. and hereby agrees to comply with the rules and regulations as now, or at any future time, established by the Board of Selectmen.

Am't of Estimate \$.....

Owner


Am't Paid \$.....

Address

Builder

.....

Sketch of Service Here

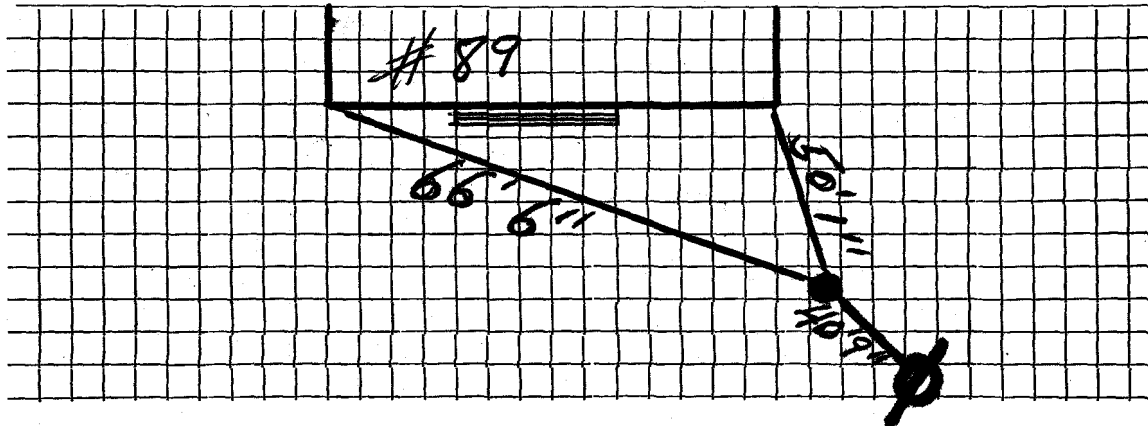

Connection made in Street.

Work completed19

Remarks: