

WATER SERVICE RECORD

#6010

Name Henry J. Moulton

Service No. 114

Address 91 North Street

Location Lexington, Mass.

~~RENEWAL~~ - New Service


Com. 8-6-51

Date	Material	Amount	Total	Date	Amount	
6/7/51	Labor	1 49	1 49	<i>June 1 '57</i>	<i>Deposited</i>	6000
	10% overhead		15			
	58' -3/4" copper tubing @ .326-18	91			No Charge	
	1 -3/4" Cx 1/2 I.W.H, stop&waste	4 00	4 00	6/7/51	Labor	5 13
	1 hr. Littlefield shovel		7 00		24' -3/4" copper tubing @ .326	7 82
	1 hr. trucking		75		1 - 3/4" C. corp-cock	4 33
	patching 18 x 3		18 00		1 - 3/4" C x 3/4" C curb-cock	4 67
			50 30		1 - 3/4" x 3/4" C.Union (3pts.)	1 72
					1 - box and rod	4 68
					1 - 1/2 offset tail piece	50
					1 - 1/2 straight tail piece	50
					1 hr. littlefield shovel	7 00
					1 hr. trucking	75
						37 10

DATE \_\_\_\_\_

TOWN OF LEXINGTON — BOARD OF PUBLIC WORKS  
WATER DIVISION

Sketch of Service Here

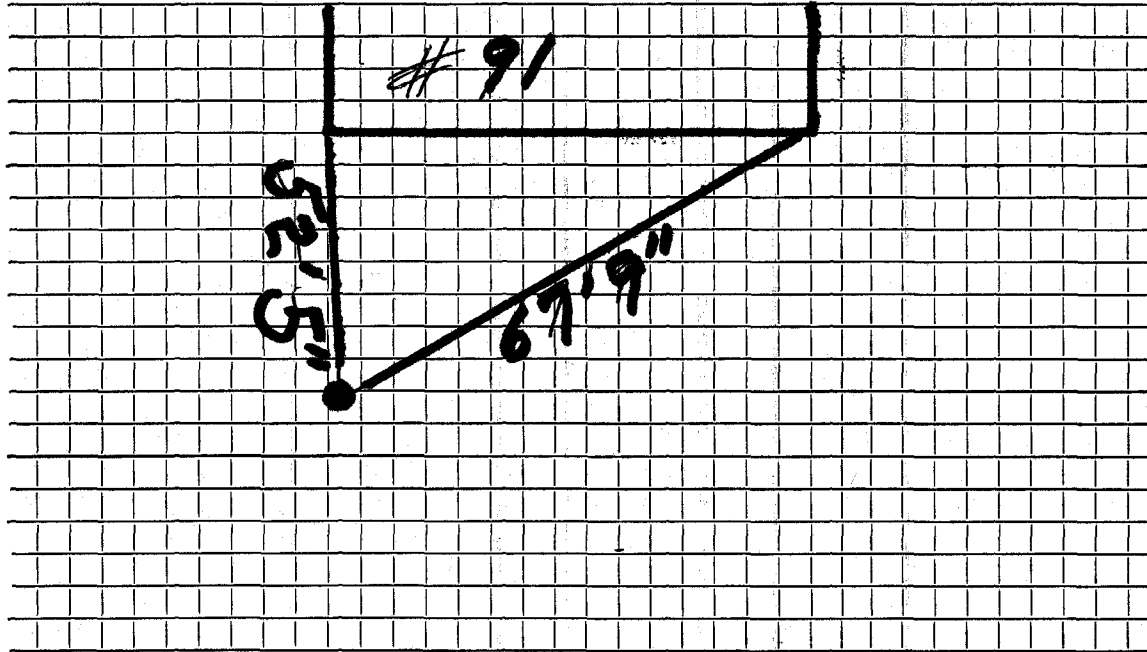

Connection made in ..... Street. Work completed .....

Remarks: .....

.....  
.....