

Name William Selfridge

Service No. 104 3203

Address 92 North Street

Lexington, Mass.

Location 92 North Street

683

Kind of Pipe

Size

Size of Main

~~Repair-Renewal~~ New Service

Com 12-30-16

Location

Date	Material	Amount	Total	Date	Amount
Nov. 9, '46	Labor	22 68	22 68	Nov. 8 '46	40 00
	10% Overhead		2 27		
	42' - $\frac{3}{4}$ " Copper Tubing @.24		10 08		
	1 - $\frac{3}{4}$ " C x $\frac{1}{2}$ " I.W.H. S & W		2 82	Nov. 9, '46	5 25
	Patching 2' x 3'		2 00	7' - $\frac{1}{2}$ " Copper Tubing @.24	1 68
	Trucking 1 hr. @.75		75	1 - $\frac{3}{4}$ " C Corp-cock	2 70
			40 60	1 - $\frac{3}{4}$ " C x $\frac{1}{4}$ " C Curb-cock	3 30
				1 - Box & Rod	3 50
				1 - $\frac{1}{2}$ " Offset Tail Piece	50
				1 - $\frac{1}{2}$ " Straight Tail Piece	50
				Trucking 1 hr. @.75	75
					18 18
	Labor				

Deposited

Non-Charge

Hadley Press, Inc., Lexington

TOWN OF LEXINGTON—BOARD OF PUBLIC WORKS

WATER DIVISION

The undersigned applies for a supply of water at No. _____ St. and hereby agrees to comply with the rules and regulations as now, or at any future time, established by the Board of Selectmen.

Am't. of Estimate \$ _____


Owner _____

Am't. Paid \$ _____

Address _____

Builder _____

Sketch of Service Here

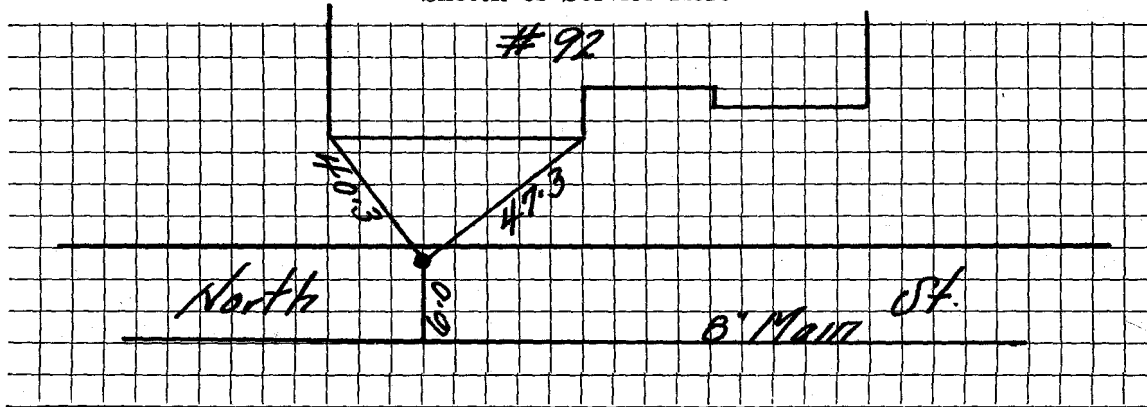

Connection made in _____ Street.

Work completed _____ 19

Remarks: