

Name William Selfridge

Service No. ⁷² 3178
~~36~~
1554

Address 94 North Street

Lexington, Mass.

Location 94 North Street

Kind of Pipe

Size

Size of Main

~~Repair - Renewal~~ - New Service

Location

Date	Material	Amount	Total	Date	Amount
June 5, '46	Labor	24 75	24 75	Aug 9, '46	40 00
	10% Overhead		2 48		
	44' - 3/4" Copper Tubing @.1815		7 99		
	1 - 3/4" C x 3/4" I.W.H. S & W		2 82	June 5, '46	3 60
	Patching 3' x 2'		2 00	6' - 3/4" Copper Tubing @.1815	1 09
	Trucking 1 hr. @.75		75	1 - 3/4" C Corp-cock	2 70
			40 79	1 - 3/4" C x 3/4" C Curb-cock	3 30
				1 - Box & Rod	3 35
				2 - 3/4" Straight Tail Pieces	1 00
				Trucking 1 hr. @.75	75
	Labor				

Repaired

Non-Charge

Hadley Press, Inc., Lexington

DATE _____

TOWN OF LEXINGTON—BOARD OF PUBLIC WORKS

WATER DIVISION

The undersigned applies for a supply of water at No. _____ St. and hereby agrees to comply with the rules and regulations as now, or at any future time, established by the Board of Selectmen.


Am't. of Estimate \$ _____

Owner _____

Am't. Paid \$ _____

Address _____

Builder _____

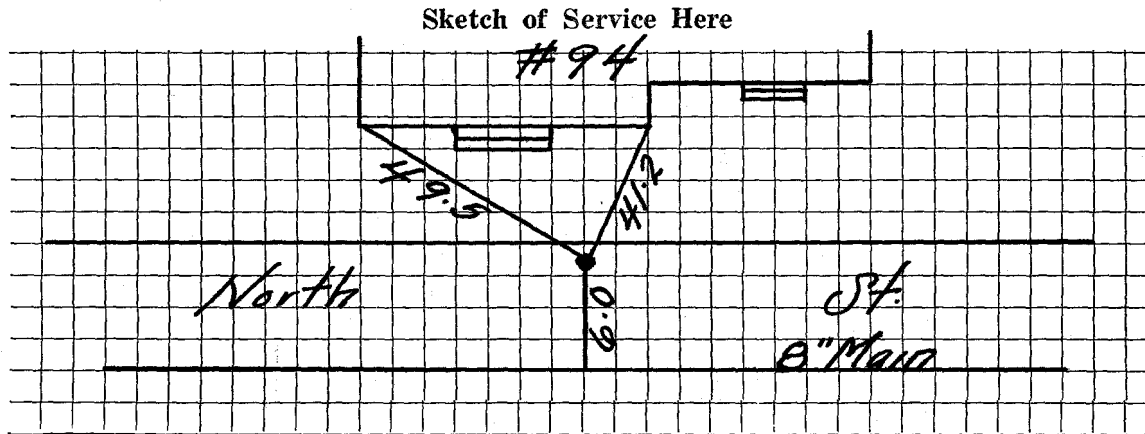

Connection made in _____ Street.

Work completed _____ 19

Remarks:

658