

WATER SERVICE RECORD

Name Henry J. Moulton

Service No. 115

1242

Address 95 North Street

1243

Location Lexington, Mass.

#5810


~~Repair-Renewal~~ - New Service Com. 8-6-51

| Date | Material | Amount | Total | Date | Amount |
|--------|--------------------------------|--------|-------|------------|---------------------------------|
| 6-7-51 | Labor | 1 49 | 1 49 | June 1 '51 | 60 00 |
| | 10% Overhead | | 15 | | 12 31 |
| | 50' - 3/4" Copper Tubing @.326 | 16 30 | | | No Charge |
| | 1 - 3/4" x 1/2" I.W.H. S&W | 4 00 | | 6-7-51 | Labor |
| | Littlefield Shovel 1 hr. @7.00 | 7 00 | | | 5 13 |
| | Trucking 1 hr. @.75 | | 75 | | 24' - 3/4" Copper Tubing @.326 |
| | Patching 18 x 3 | | 18 00 | | 1 - 3/4" Corp-cock |
| | | | 47 69 | | 1 - 3/4" x 3/4" Curb-cock |
| | | | | | 1 - 3/4" x 3/4" Union (3pts) |
| | | | | | 1 - Box & Rod |
| | | | | | 1 - 1/8" Offset Tail Piece |
| | | | | | 1 - 1/8" Straight Tail Piece |
| | | | | | Littlefield Shovel 1 hr. @ 7.00 |
| | | | | | Trucking 1 hr. @.75 |
| | | | | | 37 10 |

DATE _____

TOWN OF LEXINGTON — BOARD OF PUBLIC WORKS
WATER DIVISION

Sketch of Service Here

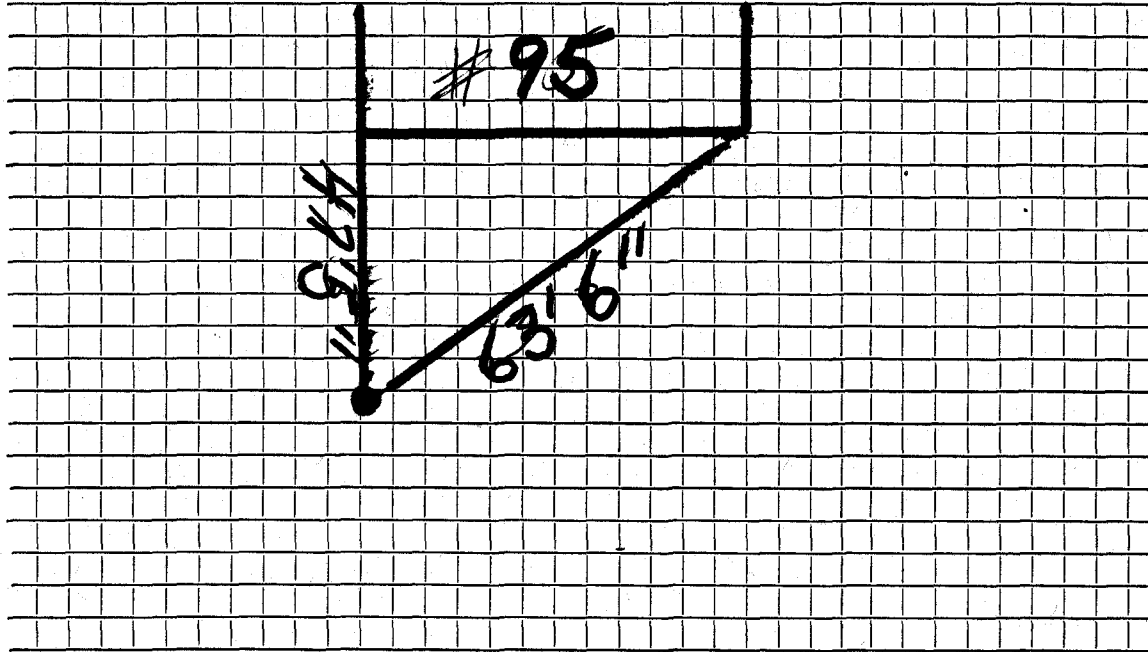

Connection made in Street. Work completed

Remarks:
.....
.....