

WATER SERVICE RECORD

Name **Fred Williams & Son**

Service No. **101**

Address **97 North Street**

Location **Lexington**

~~REPAIR WORK~~ **New Service**


Com 7-28-52

Date	Material	Amount	Total	Date	Amount
6/13/52	Labor	3 02		6-2-52 Deposited	60 00
	10% overhead	30	3 32	7-28-52 Refunded	(6 30
	60' - 3/4" copper tubing@.3439	20 63		<u>NON CHARGE</u>	53 70
	1 - 3/4" C x 1/2 I.W.H.stop & waste	4 00		6/13/52 Labor	6 40
	1 hr. Littlefield shovel		7 00	30' - 3/4" copper tubing@.3439	10 32
	1 hr. trucking		75	1 - 3/4" C. corp-cock	4 33
	patching 18 x 3		18 00	1 - 3/4" C. curb-cock	4 67
			53 70	1 box end rod	4 52
				1 - 1/2 offset tail piece	50
				1 - 1/2 straight tail piece	50
				2 hrs. Littlefield shovel	14 00
				1 hr. trucking	75
					<u>45 99</u>

DATE _____

TOWN OF LEXINGTON — BOARD OF PUBLIC WORKS
WATER DIVISION

Sketch of Service Here

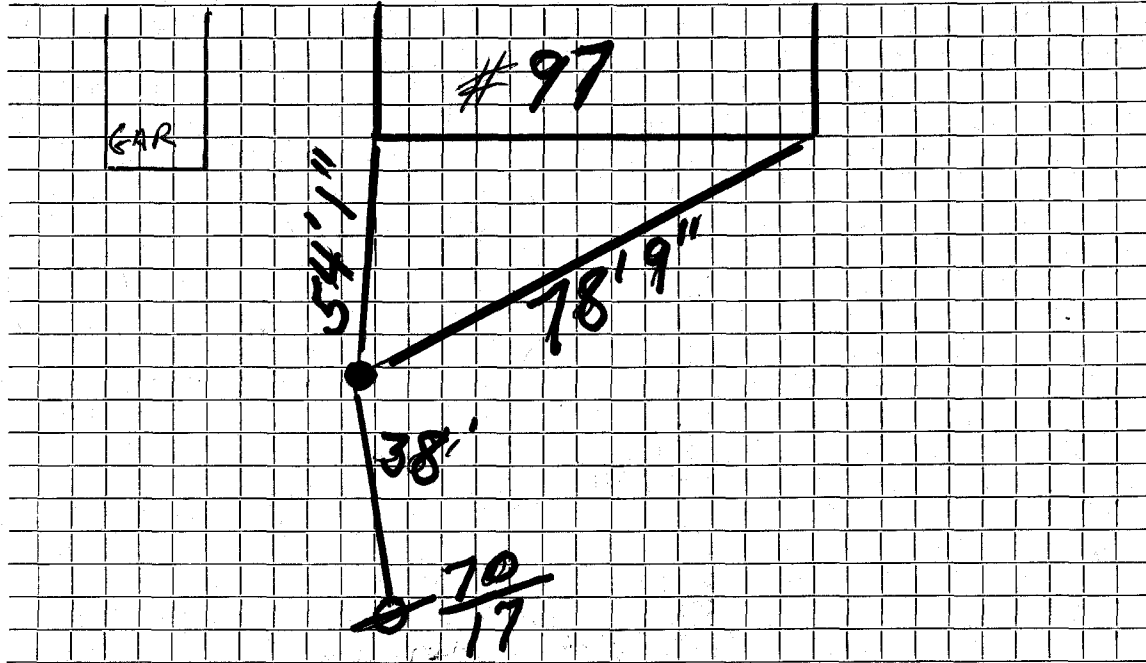

Connection made in Street. Work completed

Remarks:
.....
.....