




DATE 9-12-90

TOWN OF LEXINGTON — BOARD OF PUBLIC WORKS

WATER DIVISION

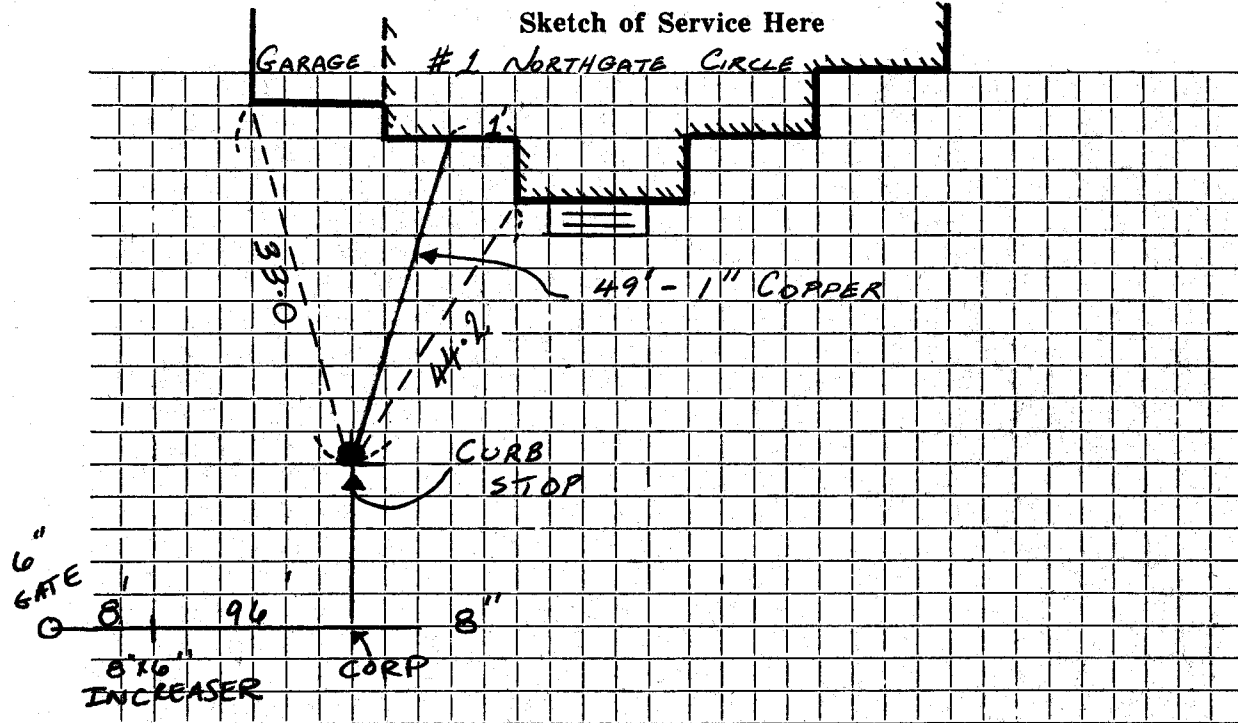

Connection made in NORTHGATE CIRCLE Street. Work completed .....

Remarks: INSPECTED 8-4-'89 BY CRG INSTALLED BY J. McLAUGHLIN .....