


DATE 7/27/92

TOWN OF LEXINGTON — BOARD OF PUBLIC WORKS

WATER DIVISION

Sketch of Service Here

#2 NORTHGATE C.I.R.

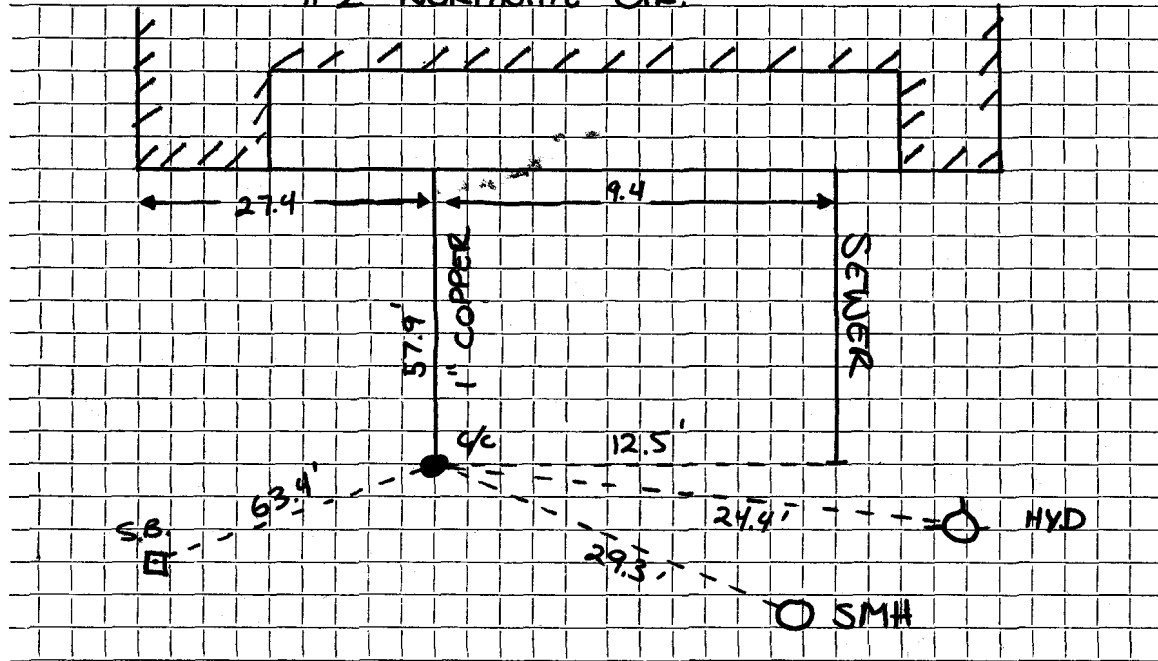

Connection made in ... NORTHGATE C.I.R. ~~Street.~~ Work completed

Remarks: ... INSTALLED BY : J. McLAUGHLIN

INSPECTED BY :