




DATE 2/2017

TOWN OF LEXINGTON — BOARD OF PUBLIC WORKS  
WATER DIVISION

Sketch of Service Here

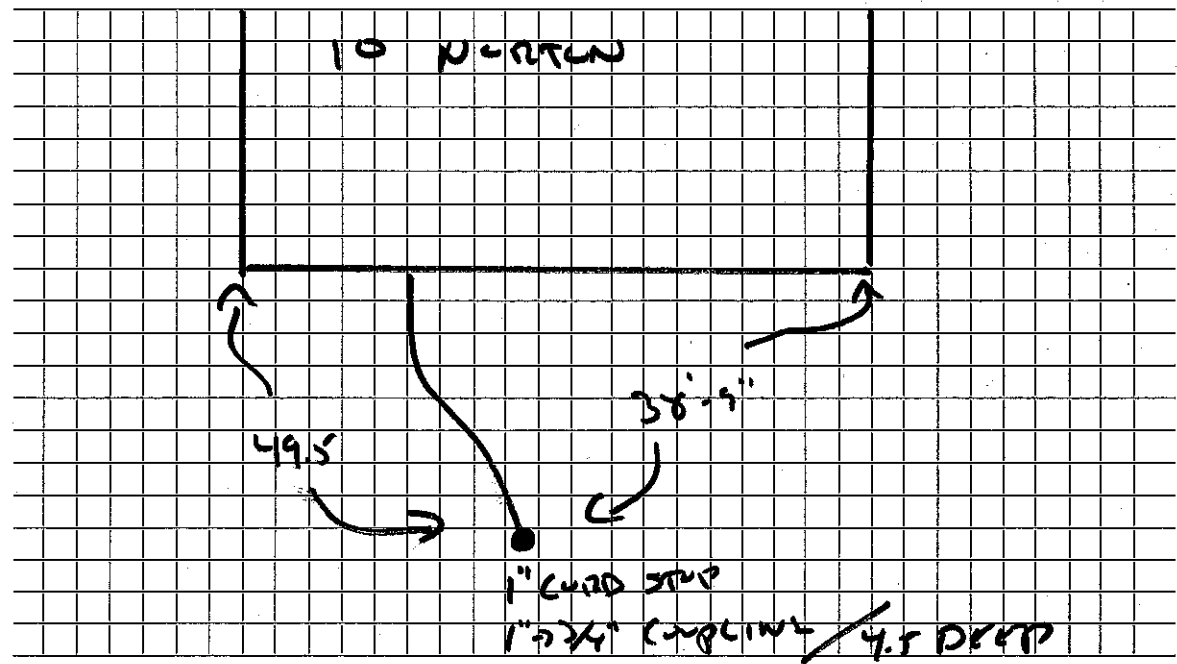

Connection made in NORTH Street. Work completed MCLAUGHLIN

Remarks: .....

.....

.....