


Date: 3/26/21

TOWN OF LEXINGTON - BOARD OF PUBLIC WORKS
WATER DIVISION

SKETCH OF SERVICE HERE

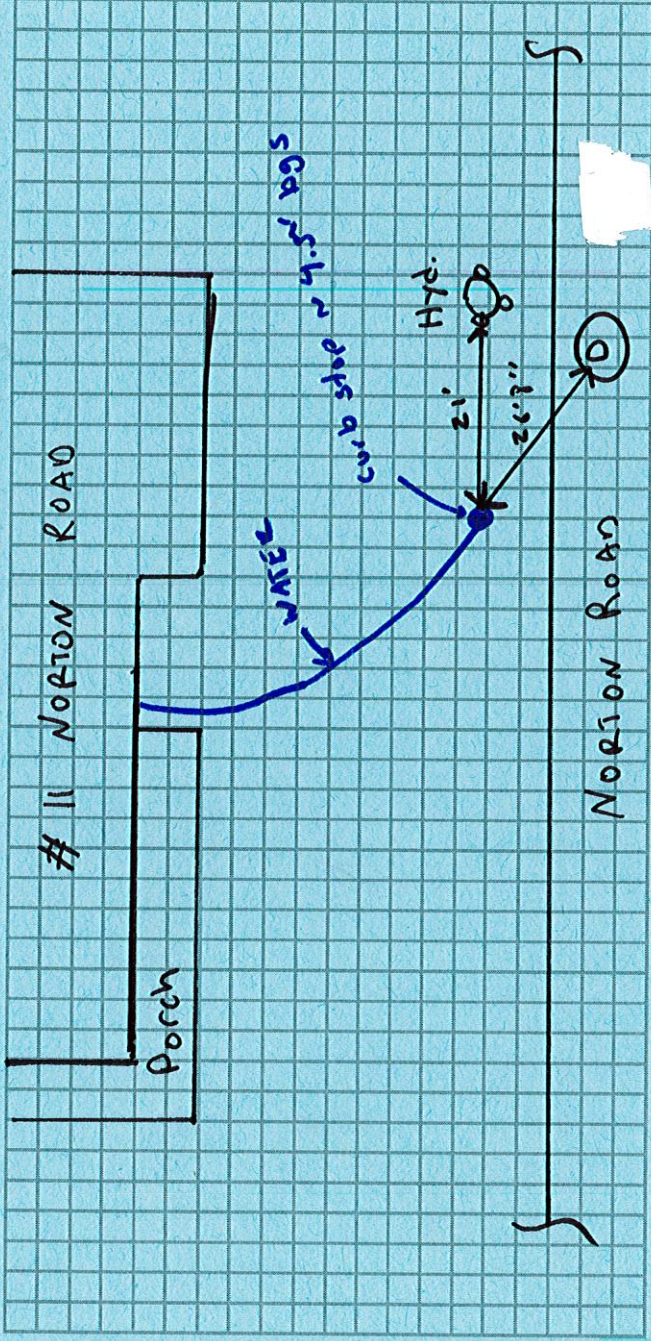

Connection made in: Norton

Street: Norton Road


Work completed: Water Renewal

Remarks:

- Inspected by ASL

TOWN OF LEXINGTON — BOARD OF PUBLIC WORKS
WATER DIVISION

Sketch of Service Here

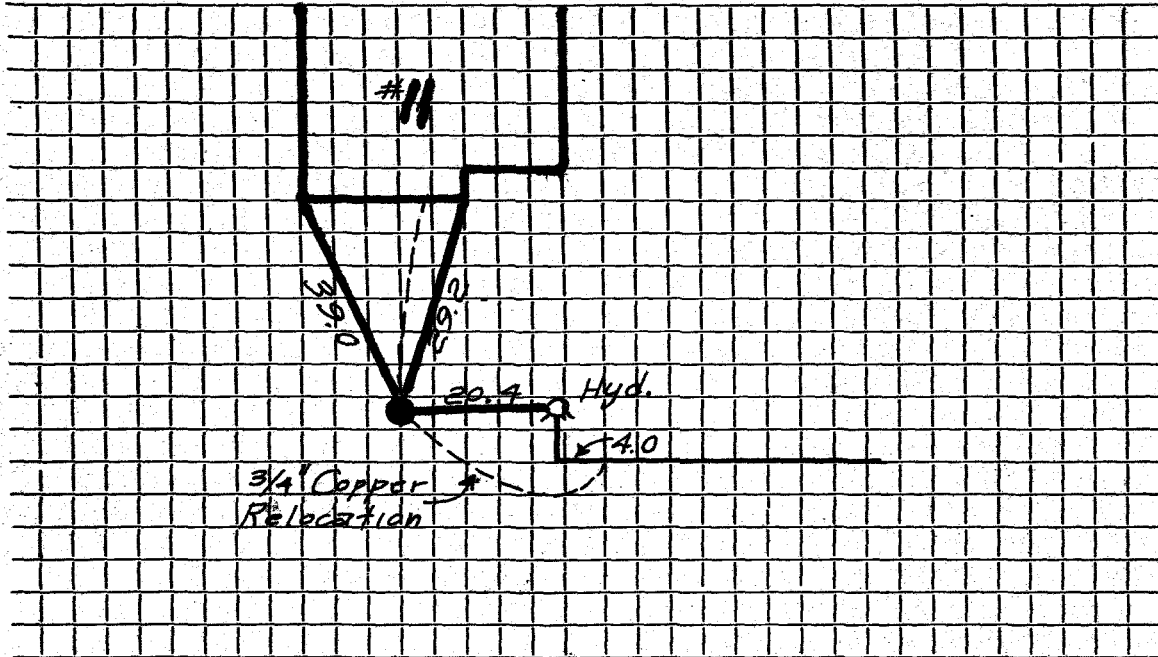

Connection made in Street. Work completed

Remarks: Original Service 11-18-40

.....
.....