

WATER SERVICE RECORD

Name

Service No.

Address 6 Norton Road

Location


Repair—~~Renewal~~ New Service

Date	Material	Amount	Total	Date	Amount	
9-30-64	Labor	43.80				
10-1-64	"	84.05	127.85			
	10% O.H.	12.79	140.64			
42'	3/4" Copper tubing @.42		17.64		CURB TO MAIN	
1	3/4" x 1/2 Comp Valve		9.29	24'	3/4" Copper tubing @.42	10.08
3	hrs. Town Shovel @6.50		19.50	1	3/4" Corp Cock	7.41
1 1/2	hrs. Trucking @3.00		4.50	1	3/4" Curb Cock	8.76
			191.57	1	Box & Rod	4.90
				1	1/2 Straight Offset	.50
				1	1/2 Straight tailpiece	.50
				3	hrs. Town Shovel @6.50	19.50
				1 1/2	hrs. Trucking @3.00	4.50
						56.15

TOWN OF LEXINGTON — BOARD OF PUBLIC WORKS

WATER DIVISION

Sketch of Service Here

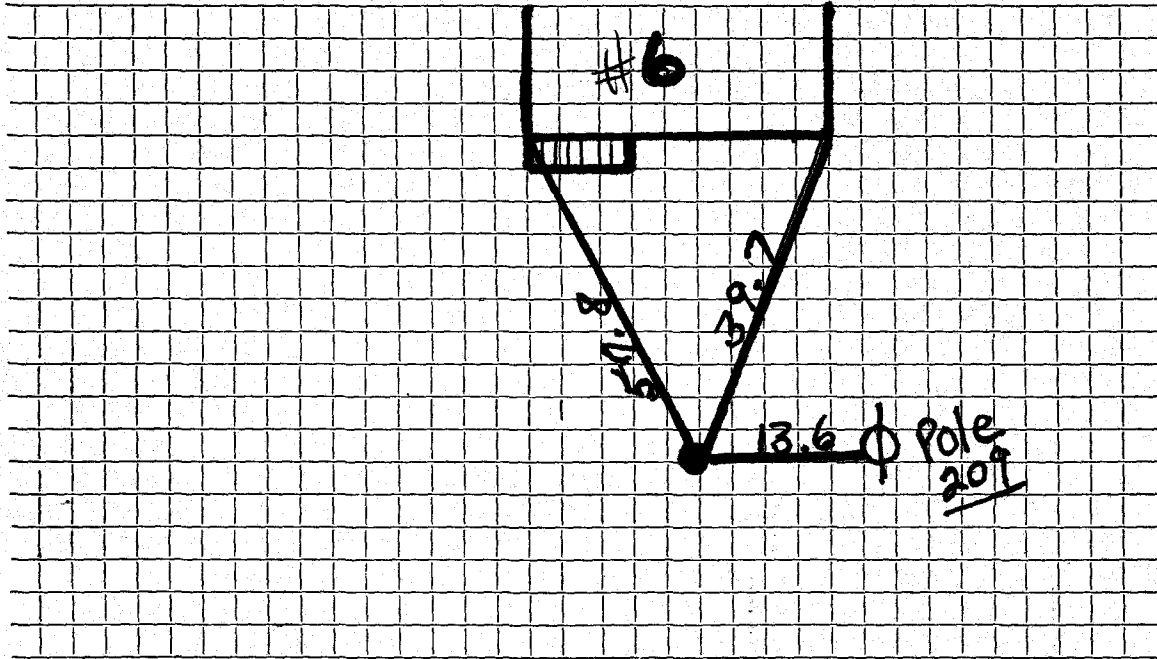

Connection made in Street. Work completed

Remarks:

.....

.....