

WATER SERVICE RECORD

5334

Name Moore Realty Trust

Service No. 16

Address #1 Nowers Rd.

7135

Location Lot 1

~~Repair - Renewal~~ New Service DeFlice Bros Permit #229

MAY 17 1965

| Date | Material | Amount | Total | Date | Amount |
|---------|------------------------|--------|-------|---------|-----------------------------|
| 4-12-65 | 58' 3/4" Copper tubing | | | 3-26-65 | Deposit 67.61 |
| | | | | | CURB TO MAIN |
| | | | | 9-2-64 | Labor 22.78 |
| | | | | | 10% O.H. 2.28 |
| | | | | | 25.06 |
| | | | | | 19' 3/4" Copper tubing @.42 |
| | | | | | 7.98 |
| | | | | | 1 3/4" C Curb Cock |
| | | | | | 8.76 |
| | | | | | 1 3/4" C Corp Cock |
| | | | | | 7.41 |
| | | | | | 1 Box & Rod |
| | | | | | 4.90 |
| | | | | | 1 hr. Town Shovel @6.50 |
| | | | | | 6.50 |
| | | | | | 1 hr. Trucking @3.00 |
| | | | | | 3.00 |
| | | | | | 1 hr. Loader @4.90 |
| | | | | | 4.90 |
| | | | | | 67.61 |



TOWN OF LEXINGTON
OFFICE OF SELECTMEN

5-8-07

Date

To *Douglas Morgan / Cynthia Sicker*

Under Article 6 section 2 of the General By-Laws of the Town of Lexington, it is ordered that "The Selectmen shall determine and designate numbers for the buildings abutting upon or adjacent to such streets or portions of streets as they may deem best for public convenience. No person shall neglect or refuse to affix to any building owned by him, the street number designated for him by said board."

The owner of the building on

33 BLAKE RD.

Street

71/279

Lot No.

is hereby notified that
the proper number is

2 NOWERS RD.


BOARD OF SELECTMEN

By *Peter Karalakis*

TOWN OF LEXINGTON — BOARD OF PUBLIC WORKS

WATER DIVISION

Sketch of Service Here

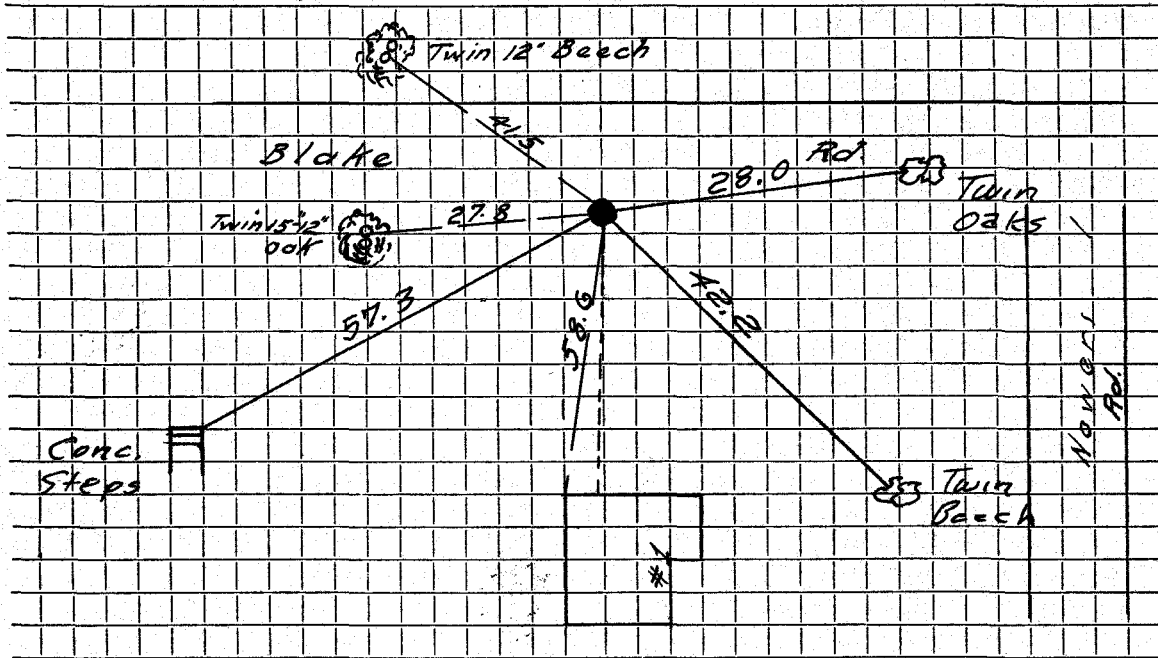

Connection made in Street. Work completed

Remarks:

.....
.....