


DATE 9-24-2001

TOWN OF LEXINGTON — BOARD OF PUBLIC WORKS
WATER DIVISION

Sketch of Service Here

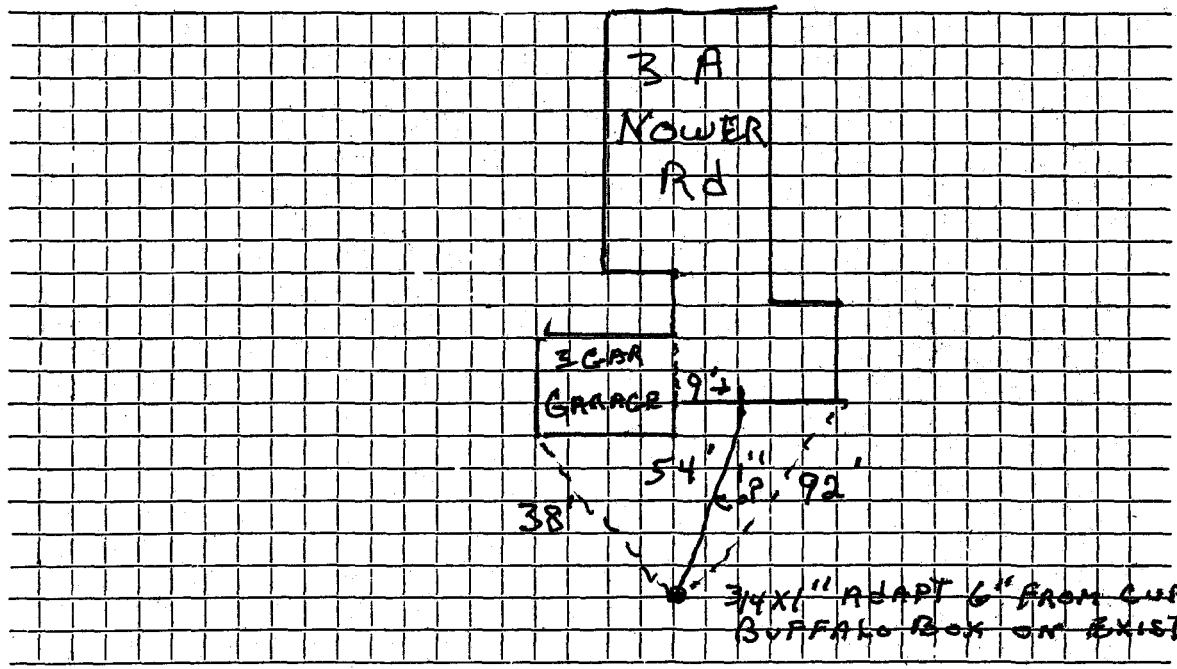

FRONT OF HOUSE
FACES NOWER Rd

BACK OF HOUSE
BURLINGTON ST

3/4" x 1" ADAPT 6" FROM CURB.
BUFFALO BOX ON EXISTING CURB.

Connection made in BURLINGTON Street. Work completed

Remarks: INSTALLED BY J. McLAUGHLIN

IN FILE IN METER ROOM. LOOK UNDER BURLINGTON ST.