

WATER SERVICE RECORD

Name John Cody

Service No. 222

Address 3 Nowers Road

Location Lexington, Mass.

~~Revised~~ New Service

P.M. 11-13-51


Date	Material	Amount	Total	Date	Amount
10/6/51	Labor	4 14	4 14	9-15-51 Deposited	60 00
	10% overhead		41	11-13-51 Refunded	17 14
	60' -3/4" copper tubing@.326	19 56	19 56		<u>42 86</u>
	1 -3/4" Cx 1/2 I.W.H. stop&waste	4 00	4 00	10/6/51 Labor	4 14
	2 hrs. Littlefield shovel@7.00	14 00	14 00	40' -3/4" copper tubing@.326	13 04
	1 hr. trucking		75	1 -3/4" C. corp-cock	4 33
			42 86	1 -3/4" C x 3/4" C. curb-cock	4 67
				1 - box and rod	4 68
				1 - 1/2 straight tail piece	50
				1 - 1/2 offset tail piece	50
				2 hrs. Littlefield shovel@7.00	14 00
				1 hr. trucking	75
					<u>46 61</u>

DATE _____

TOWN OF LEXINGTON — BOARD OF PUBLIC WORKS

WATER DIVISION

Sketch of Service Here

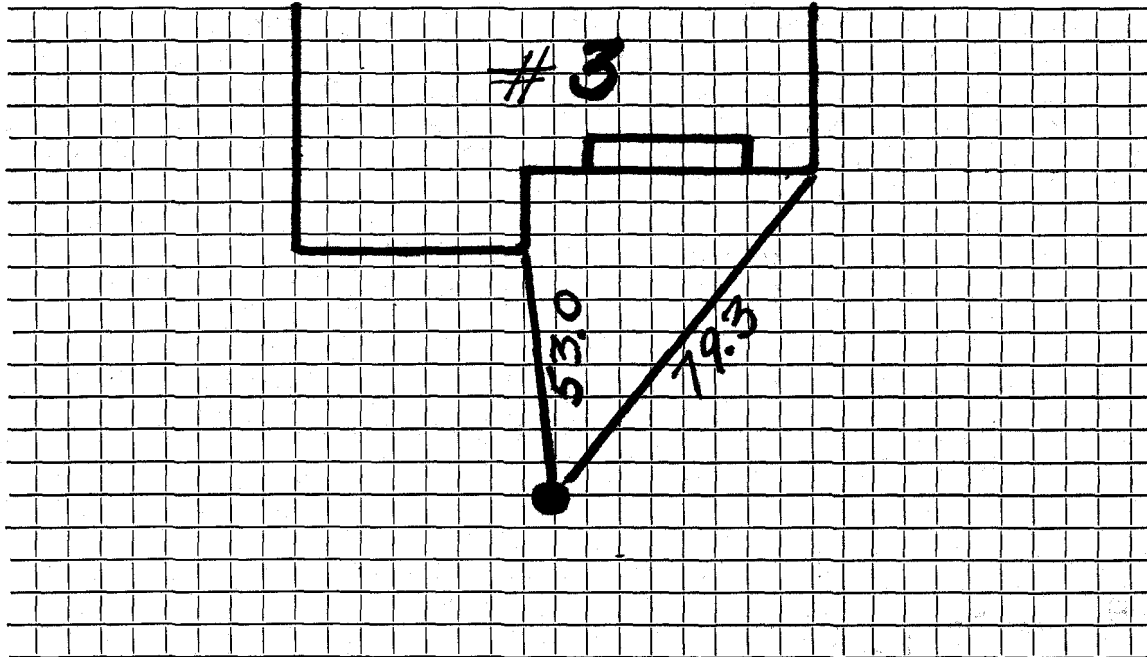

Connection made in Street. Work completed

Remarks:

.....

.....