

WATER SERVICE RECORD

1594

Name Leeland Const. Co.

Service No. 317

Address 6 Nowers Road

Location Lexington, Mass.

~~Repair/Extension~~ - New Service

COM. 2-18-52


Date	Material	Amount	Total	Date	Amount
2/2/52	Labor	4 45	4 45	12-7-51	Deposited 45 00
	10% overhead		45	2-19-52	Refunded (7 59)
	40' - 3/4" copper tubing @ .3439	13 76	13 76		<u>NON CHARGE</u> 37 41
	1 - 3/4" C x 1/2 I.W.H. stop & waste	4 00	4 00	2/2/52	Labor 4 46
	2 hrs. Littlefield shovel @ 7.00	14 00	14 00	12' - 3/4" copper tubing @ .3439	4 13
	1 hr. trucking		75	1 - 3/4" Copper Corp. Cock	4 33
			37 41	1 - 3/4" C x 3/4" C. curb-cock	4 67
				1 - box and rod	4 52
				1 - 1/2 straight tail piece	50
				1 - 1/2 offset tail piece	50
				2 hrs. Littlefield shovel	14 00
				1 hr. trucking	75
					<u>37 86</u>

DATE _____

TOWN OF LEXINGTON — BOARD OF PUBLIC WORKS

WATER DIVISION

Sketch of Service Here

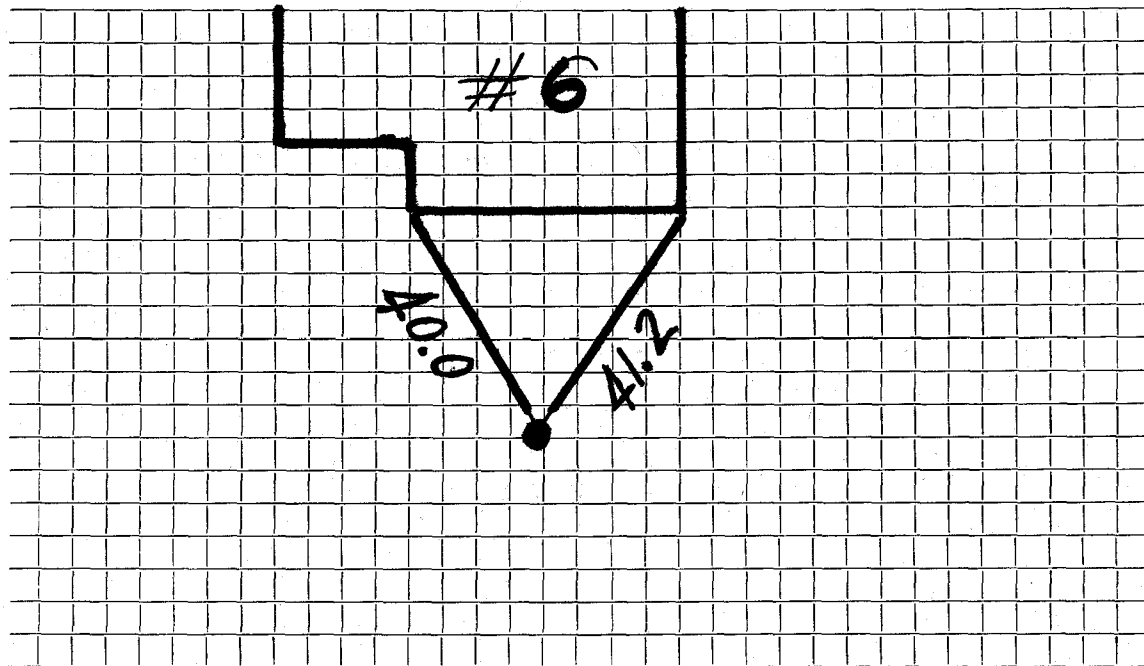

Connection made in Street. Work completed

Remarks:

.....

.....