

WATER SERVICE RECORD

Name Donald Irwin

Service No.

116

Address 8 Nowers Rd.

Location Lexington

~~Water Service~~ New Service

COM. 6-8-53


Date	Material	Amount	Total	Date	Amount
5/13/53	Labor	7 09			
	10% overhead	71	7 80	6-23-53	37 05
	50' -3/4" Copper Tubing @.34		17 00		NON CHARGE
	1-3/4" C x 1/2" I.W.H. Stop & Waste		4 00	5/13/53	Labor
	1 Hr. Littlefield Shovel		7 50		24' -3/4" Copper Tubing @.34
	1 Hr. Trucking		75		1-3/4" C. Corp-cock
			37 05		1-3/4" C x 3/4" C, Curb-cock
					1-Box & Red
					1-1/2" straight tail piece
					1-1/2" offset tail piece
					1 Hr. Littlefield Shovel
					1 Hr. Trucking
					39 61
					bill sent 6-8-53

DATE _____

TOWN OF LEXINGTON — BOARD OF PUBLIC WORKS

WATER DIVISION

Sketch of Service Here

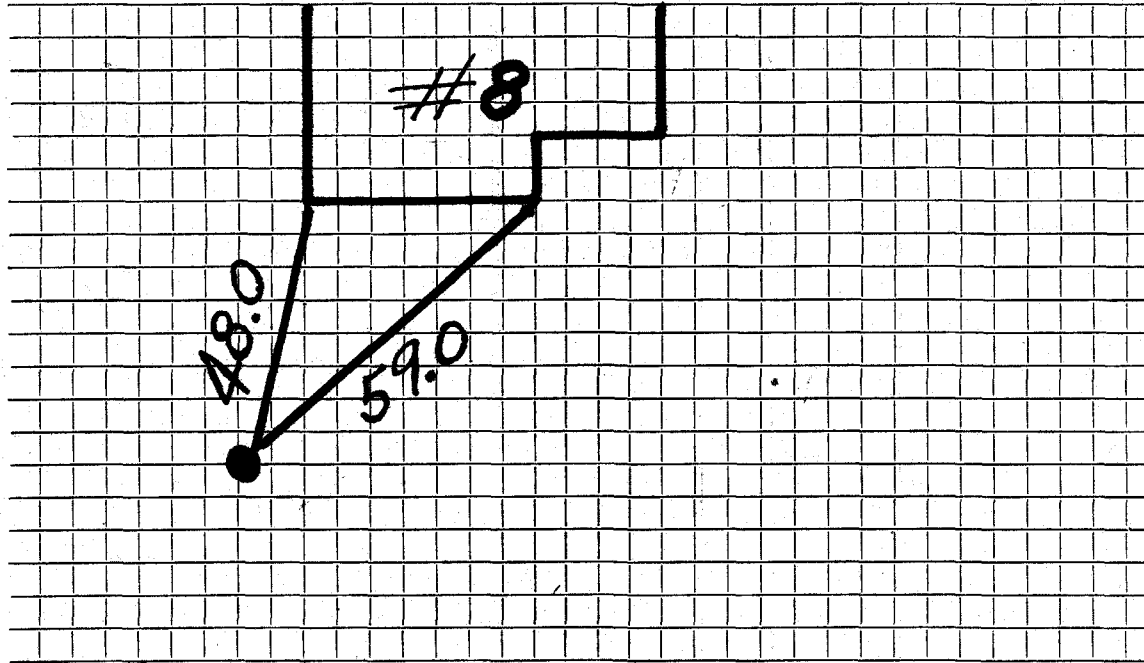

Connection made in Street. Work completed

Remarks:

.....

.....