


DATE _____

TOWN OF LEXINGTON — BOARD OF PUBLIC WORKS
WATER DIVISION

Sketch of Service Here

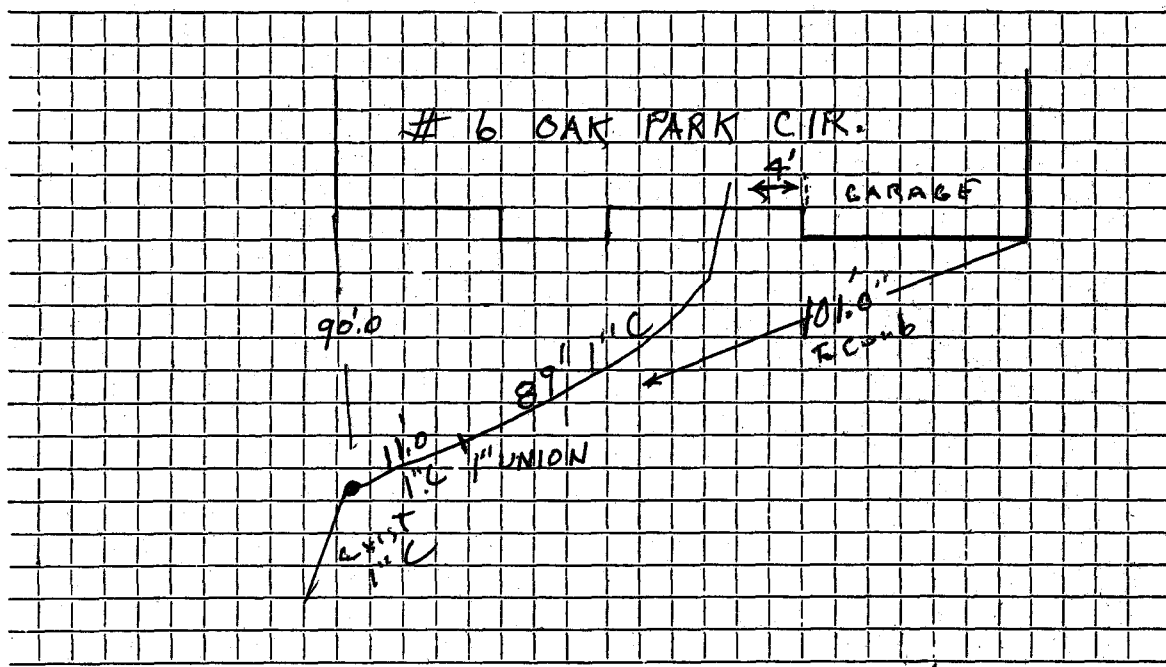

Connection made in Street.

Work completed .. 1/21/05 .. J. McLaughlin

Remarks:
.....
.....