

WATER SERVICE RECORD

Name *Alan Wilson*

Service No.

Address *33 Oak Street*

Location

Repair—Renewal—New Service
XXXXXXXXXXXX


McLaughlin #4400

Date		Material	Amount	Total	Date			Amount
<i>7/2/87</i>	<i>89'</i>	<i>1" Copper</i>						
		<i>1" Valve</i>						
							<i>OUTSIDE</i>	
					<i>7/2/87</i>	<i>21'6"</i>	<i>1" Copper</i>	
							<i>1" Corp.</i>	
							<i>1" Curb Comp.</i>	
							<i>Box & Rod</i>	

TOWN OF LEXINGTON — BOARD OF PUBLIC WORKS

WATER DIVISION

Sketch of Service Here

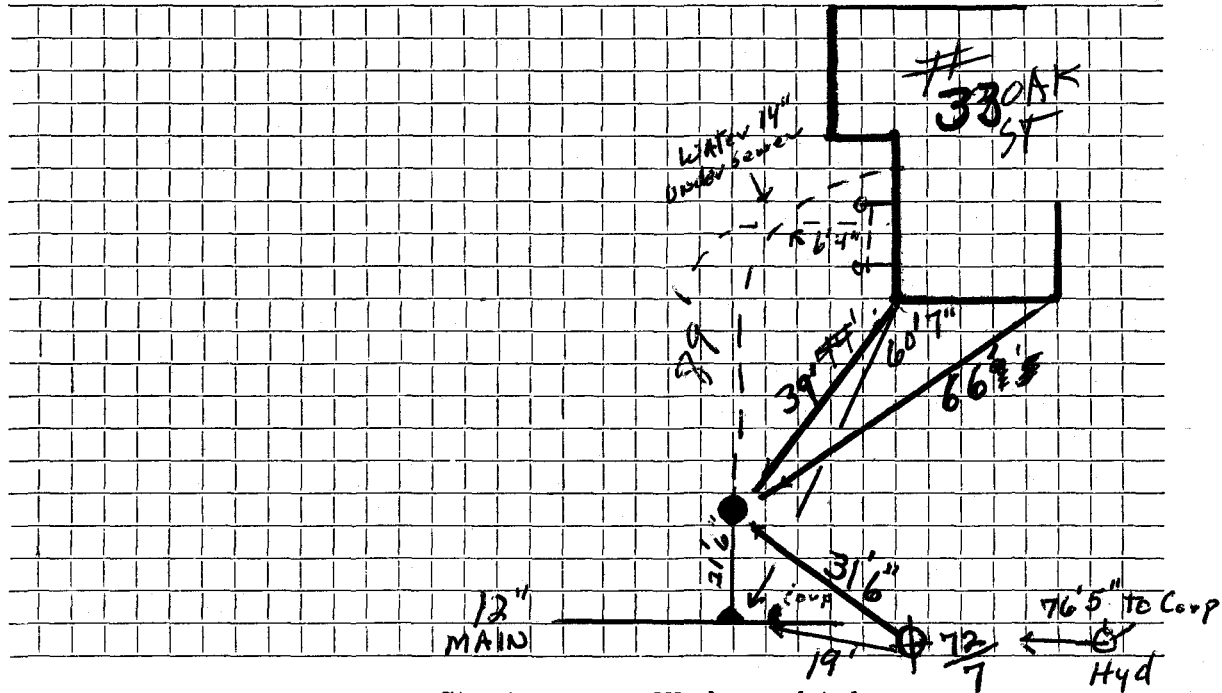

Connection made in Street. Work completed

Remarks: *Old Corp. 1' From new Corp.*

